




	jBox_Level 05	
		Ele ^c Bottom of jBox to Floor
JB***MPS-1 (23)		11'-0"
JB***MPS-1 (27) (HX-1, HX-2)		9'-0" to 1'-0"
JB***MPS-2 (150)		11'-0" to 1'-0"
JB***MPS-2 (18C)		11'-0" to 11'-3/4"
JB***MPS-2 (113A)		11'-0"
JB***MPS-2 (19)		11'-0"
JB***MPS-2 (198)		11'-0"
JB***EMPS-6 (7)		11'-0" to 11'-3/4"
JB***EMPS-6 (5)		9'-0"
JB***EMPS-6 (4)		8'-0" to 1'-0"
JB***EMPS-1 (7)		11'-0" to 1'-0"
JB***EMPS-1 (4)		11'-0" to 1'-0"
JB***EMPS-1 (4)		11'-0"
JB***EMPS-2 (6)		11'-0"
JB***EMPS-1 (3)		11'-0"
JB***EMPS-1 (3B) (DOAS-1B EX)		11'-0"
JB***EMPS-1 (3A) (DOAS-1A EX)		11'-0"
JB***EMPS-3 (17) (RT-1)		11'-0"
JB***EMPS-2 (6B)		11'-0"
JB***EMPS-2 (6A)		11'-0"
JB***EMPS-1 (1) (DOAS-1A SU)		11'-0"
JB***EMPS-1 (5) (BT-2)		7'-1"
JB***EMPS-1 (4) (BT-1)		7'-1"
JB***ROOF-MPS-1 (E) (DOAS-3 L TGTREC)		12'-4"
JB***ROOF-MPS-3 (EAHLU2)		11'-0" to 11'-3/4"
JB***ROOF-MPS-4 (EP-3A)		11'-0"
JB***ROOF-MPS-4 (EP-3B)		11'-0"
JB***ROOF-MPS-4 (EP-2A)		11'-0" to 11'-3/4"
JB***ROOF-MPS-4 (EP-2B)		11'-0" to 11'-3/4"
JB***EMPS-1 (2) (DOAS-3A SU)		11'-0"
JB***EMPS-1 (2) (DOAS-3)		11'-0" to 11'-3/4"
JB***EMPS-2 (4)		11'-0" to 11'-3/4"
JB***EMPS-4 (3)		11'-0" to 11'-3/4"
JB***EMPS-4 (3)		11'-0" to 11'-3/4"
JB***EMPS-5 (1)		11'-0" to 11'-3/4"
JB***EMPS-1 (5)		11'-0" to 11'-3/4"
JB***EMPS-1 (1)		11'-0" to 11'-3/4"
JB***EMPS-1 (1)		11'-0" to 11'-3/4"

JBox_Level 05	
Comments	Elev. Bottom of JBox to Floor
JBox***MPS-1 (FC)	10'-0" 6 1/2"
JBox***MPS-1 (7)	10'-0" 12"
JBox***MPS-1 (7)	10'-0" 4 1/2"
JBox***MPS-1 (7B)	12'-0" 4 1/2"
JBox***MPS-1 (7C)	11'-0" 1 1/2"
JBox***PPS-2 (12)	9'-0" 9 1/2"
JBox***PPS-2 (13)	9'-0" 9 1/2"
JBox***PPS-2 (14A)	9'-0" 12"
JBox***MPS-2 (20) CP-1+2, CP-3+4)	9'-0" 1 1/2"
JBox***PPS-3 (1)	10'-0" 5"
JBox***EPFS-3 (3)	10'-0" 5"
JBox***PPS-3 (11)	10'-0" 5"
JBox***PPS-3 (10)	10'-0" 5"
JBox***PPS-3 (3)	10'-0" 5"
JBox***MPS-4 (6)	10'-0" 5"
JBox***PPS-3 (6)	10'-0" 5"
JBox***EMP5-4 (2)	10'-0" 5"
JBox***EMP5-4 (1)	10'-0" 5"
JBox***EPFS-1 (1)	10'-0" 5"
JBox***PPS-2 (14)	10'-0" 5"
JBox***MPS-4 (1)	11'-0" 10 1/2"
JBox***MPS-3 (3)	12'-0" 14"
JBox***MPS-4 (4)	12'-0" 3 3/4"
JBox***PPS-2 (4)	10'-0" 11 1/4"
JBox***PPS-2 (2)	10'-0" 16"
JBox***PPS-2 (16)	11'-0" 13 3/4"
JBox***HLPS-1 (CR1R1.5, 3)	11'-0" 13 3/4"
JBox***EHLPS-1 (CR1R1.2, 2)	10'-0" 13 3/4"
JBox***EHLPS-1 (CR1R1.2, 2)	10'-0" 13 3/4"
JBox***EHLPS-1 (CR1R1.2, 2)	10'-0" 8 3/4"
JBox***HLPS-1 (CR1R1)	10'-0" 8 3/4"
JBox***HLPS-1 (CR1R1)	10'-0" 8 3/4"
JBox***EHLPS-1 (CR1R1.2, 2)	10'-0" 8 3/4"
JBox***HLPS-1 (CR1R1)	10'-0" 8 3/4"

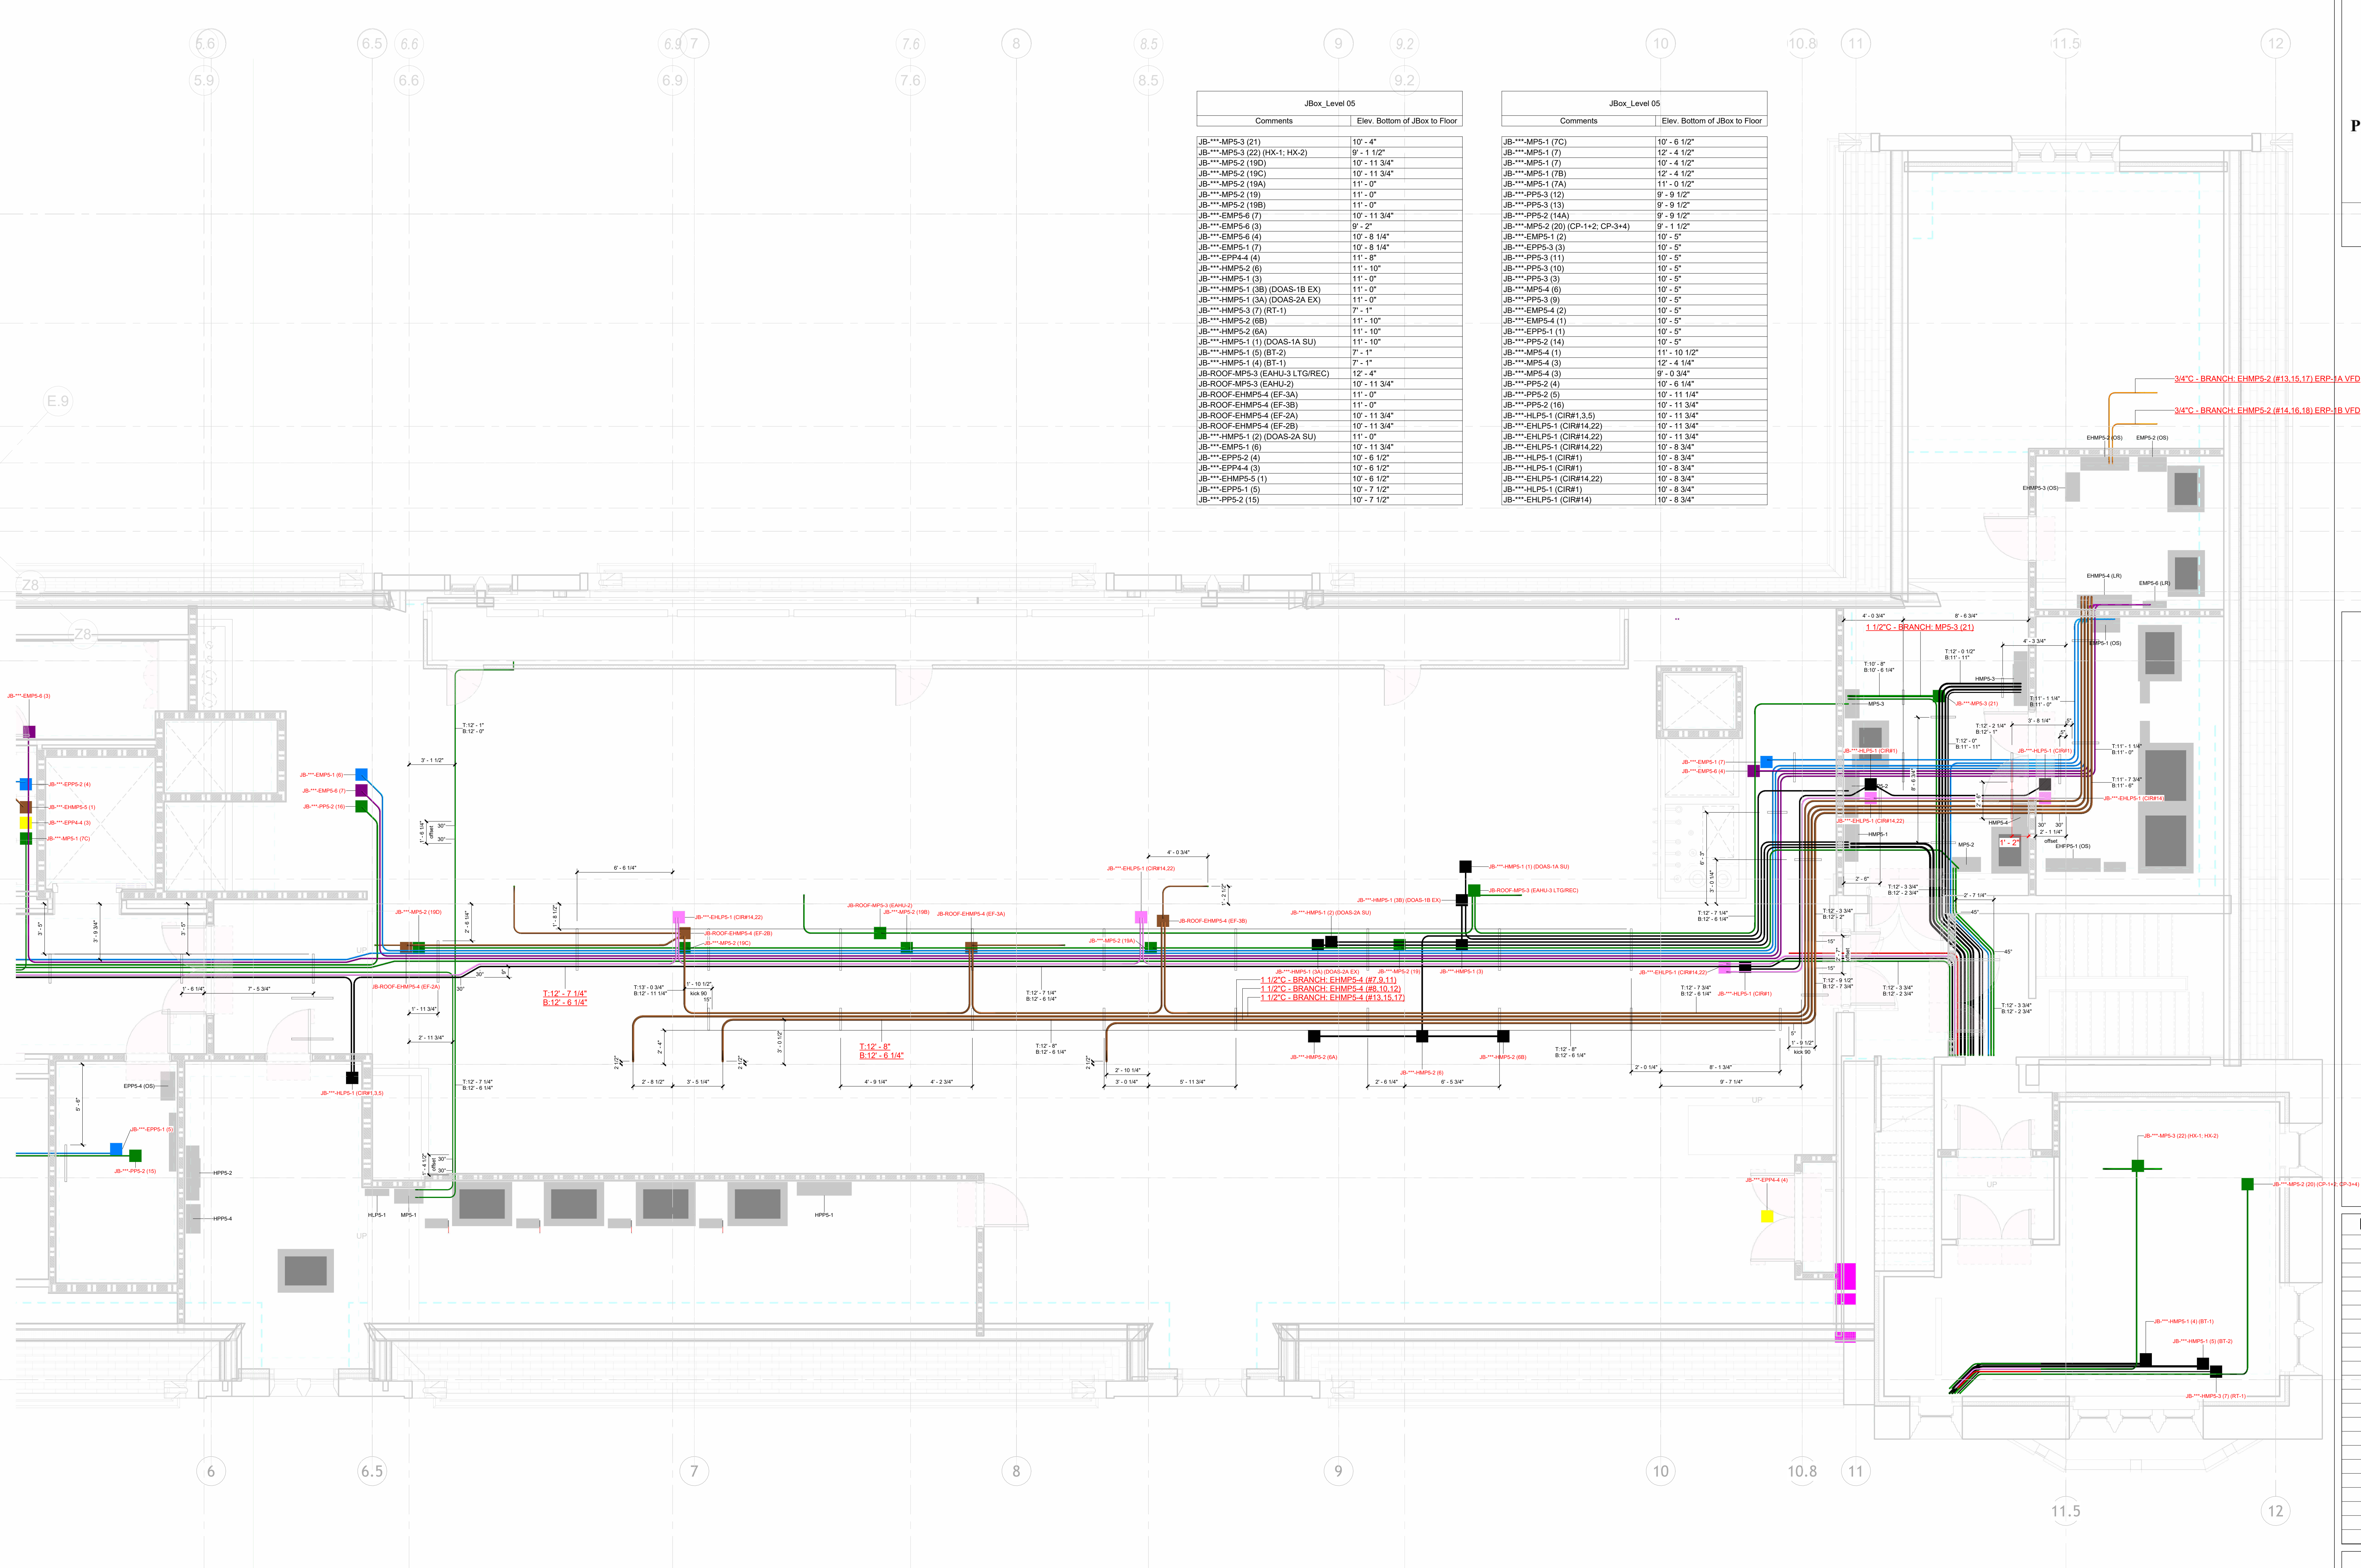

① LEVEL 05C - BRANCH
1/4" = 1'-0"

<u>Conduit Color Code</u>			
	Green	Normal	208/120V
	Black	Normal	480/277V
	Blue	EM	208/120V
	Orange	EM	480/277V
	Yellow	LS	208/120V
	Pink	LS	480/277V
	Purple	LR	208/120V
	Brown	LR	480/277V
	Red	FA	
	Magenta	TELCOM	
	Cyan	ATS	

[illegible]

YALE OML

ELECTRICAL
BRANCH

Project Number	390222
Date	5/13/2018
Drawn By	Author
Checked By	Checker

E35 05C

Scale As indicated

5/13/2026 12:51:17 PM