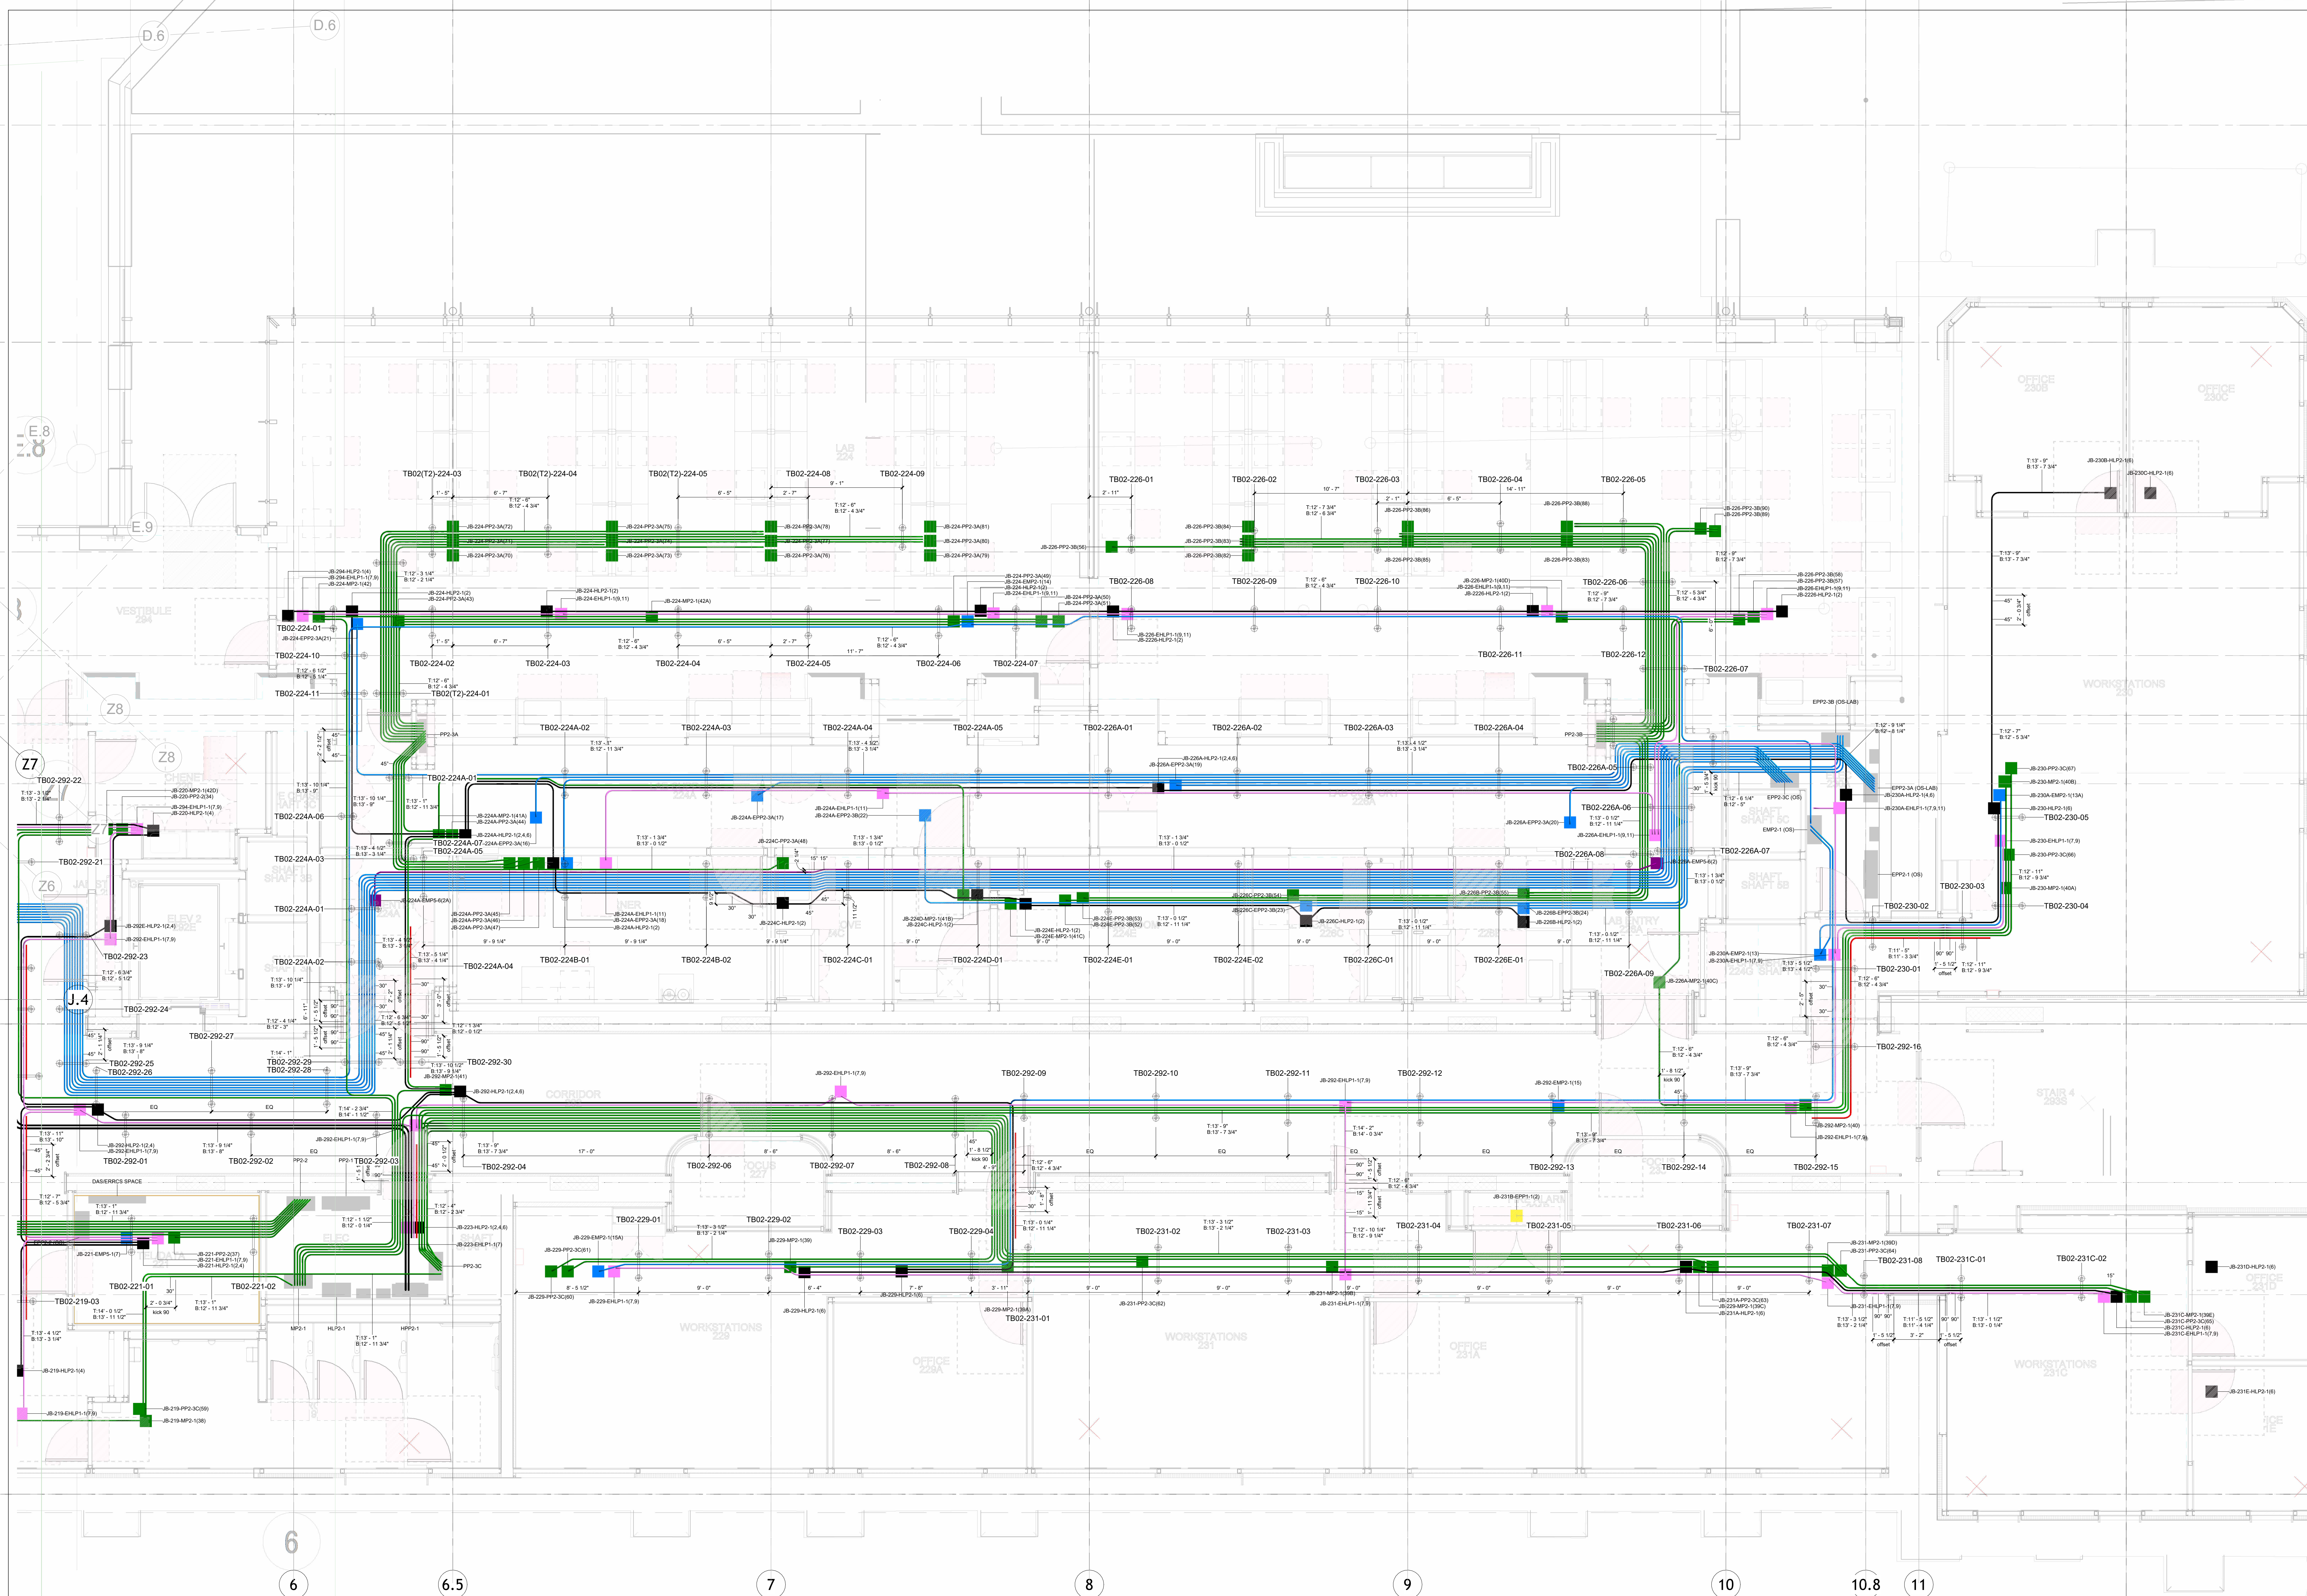


[illegible]

YALE OML

ELECTRICAL
BRANCH

Project Number	39022
Date	5/19/2018
Drawn By	Author
Checked By	Checker

E35_02C

Scale As indicated

① LEVEL 02C - BRANCH
1/4" = 1'-0"

Conduit Color Costs 11.5

Green	Normal	208/120V
Black	Normal	480/277V
Blue	EM	208/120V
Orange	EM	480/277V
Yellow	LS	208/120V
Pink	LS	480/277V
Purple	LR	208/120V
Brown	LR	480/277V
Red	FA	
Magenta	TELCOM	
Cyan	ATS	