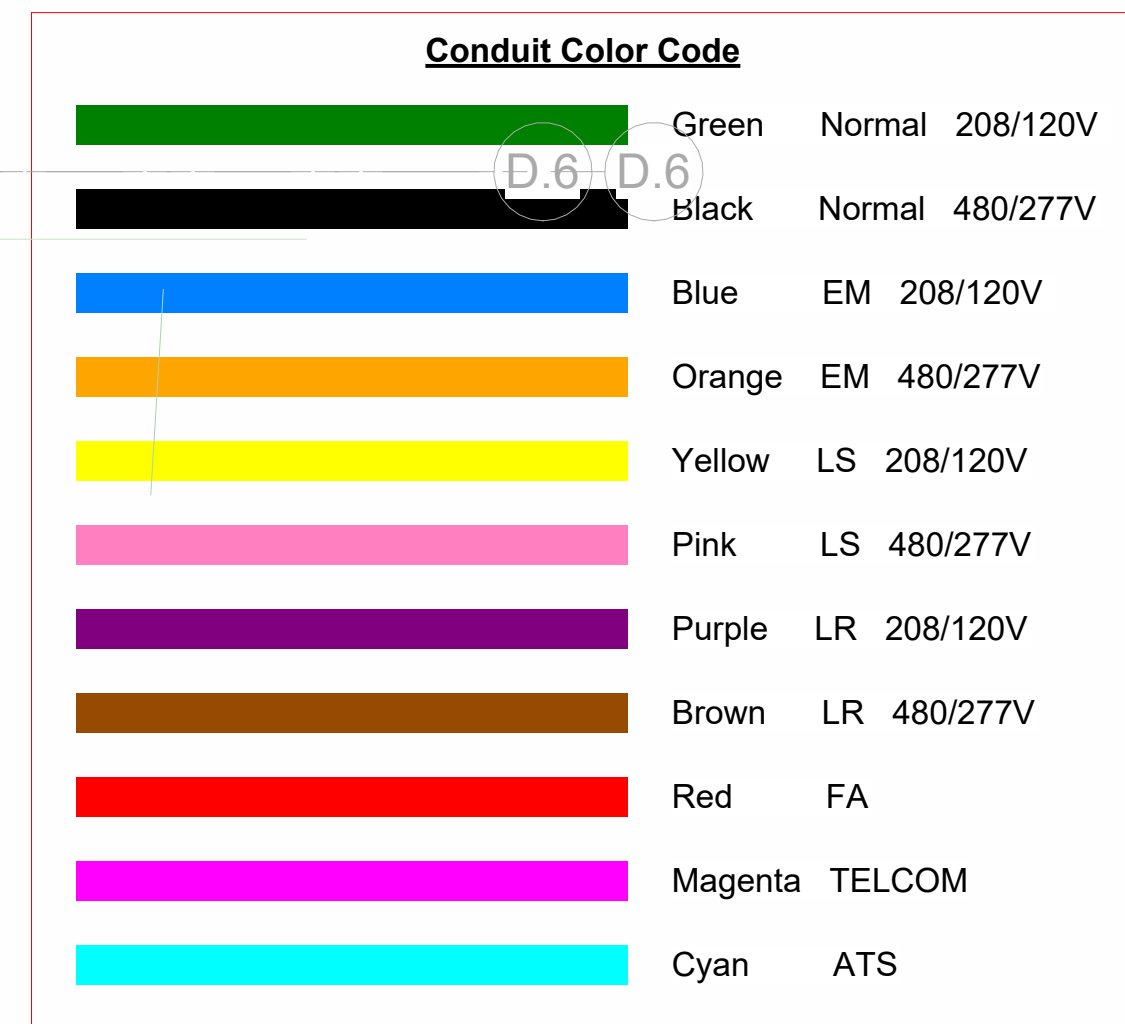


[illegible]

ELECTRICAL
BRANCH

E35 03A

Scale As indicated

11/28/2026 11:28:05 AM