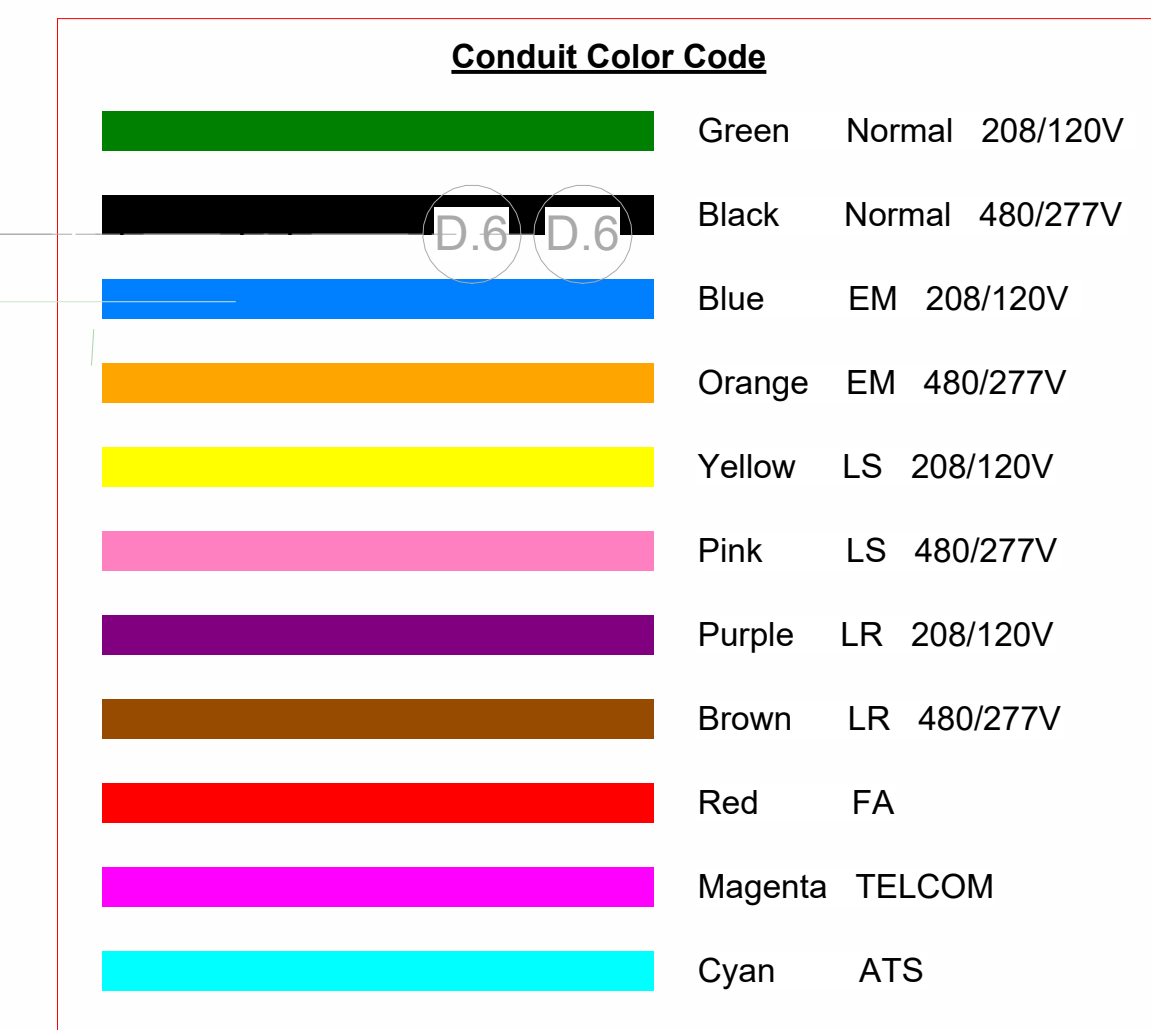


[illegible]

ELECTRICAL
BRANCH

E35_04A

Scale As indicated