
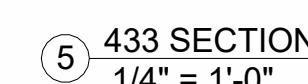
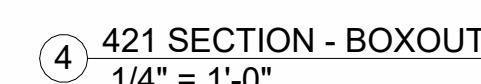
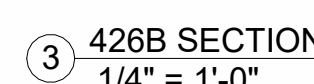


ELECTRICAL
BRANCH

E35 04C

As in

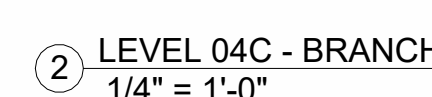

<u>Conduit Color Code</u>			
	Green	Normal	208/120V
	Black	Normal	480/277V
	Blue	EM	208/120V
	Orange	EM	480/277V
	Yellow	LS	208/120V
	Pink	LS	480/277V
	Purple	LR	208/120V
	Brown	LR	480/277V
	Red	FA	
	Magenta	TELCOM	
	Cyan	ATS	