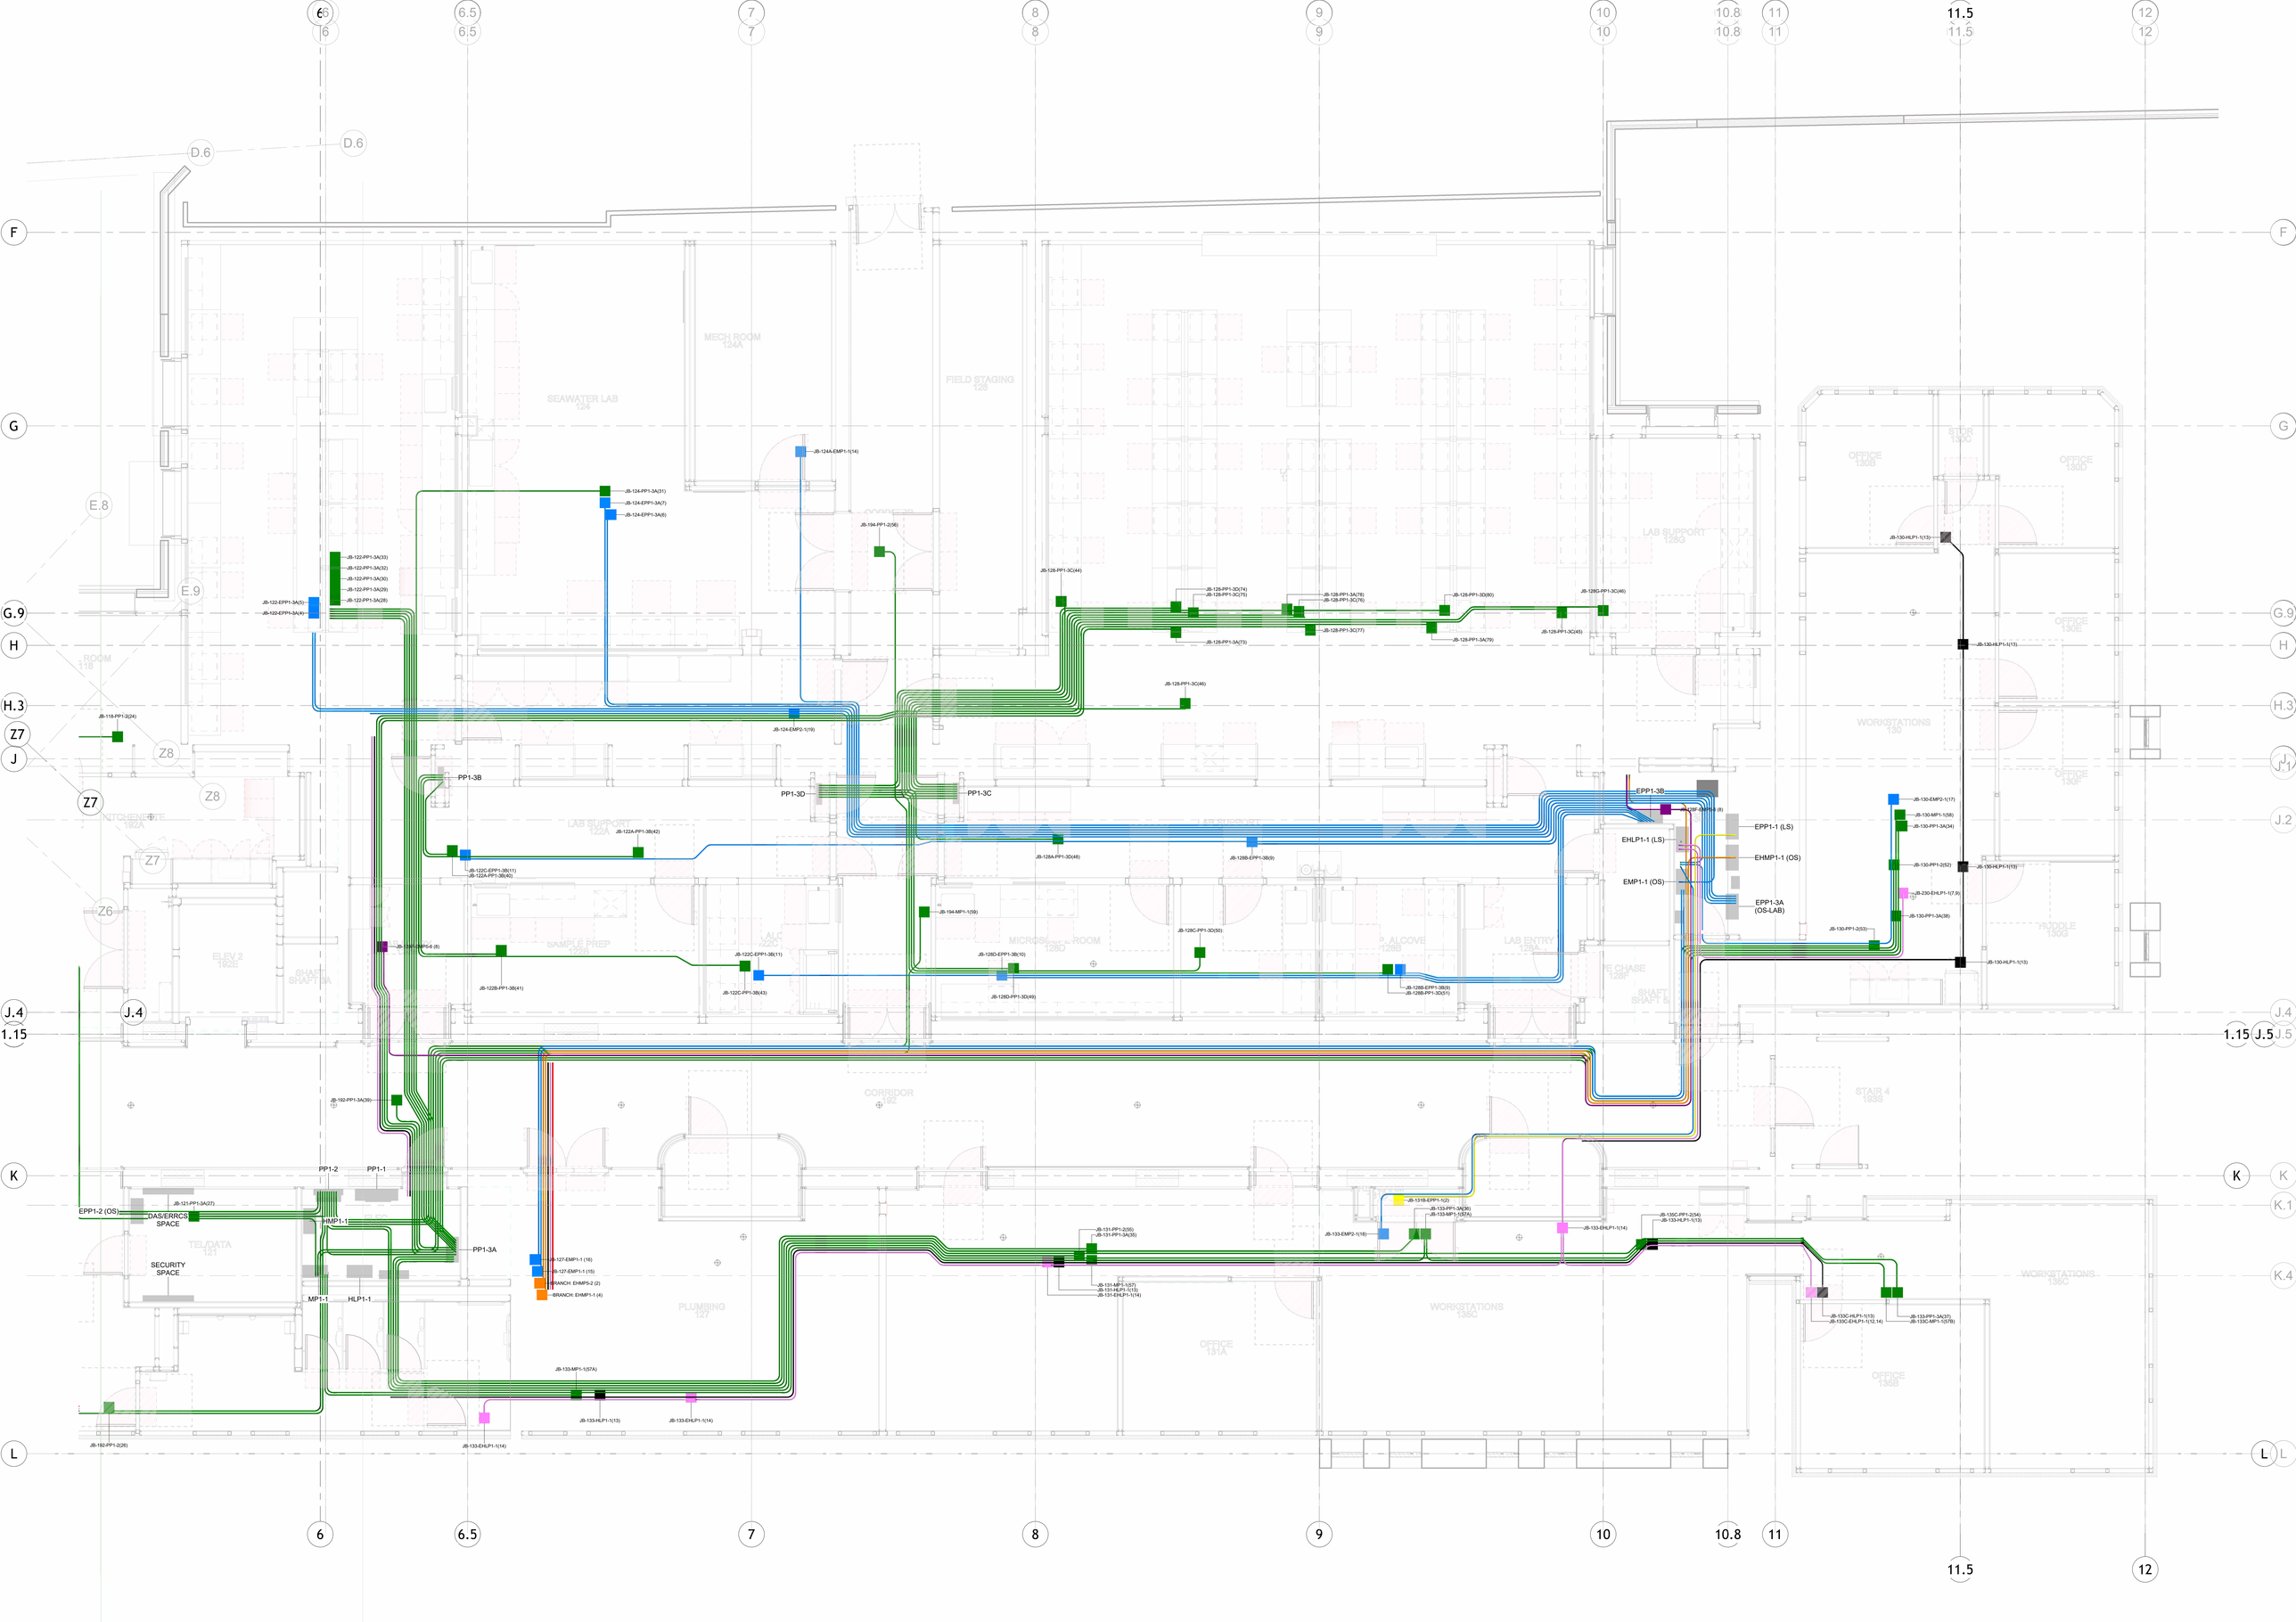

JB-124A-EMP1-1(14)
JB-124-PP1-3A(31)
JB-124-EPP1-3A(7)
JB-124-EPP1-3A(6)
JB-194-PP1-2(56)
JB-122-PP1-3A(33)
JB-122-PP1-3A(32)
JB-122-PP1-3A(30)
JB-122-PP1-3A(29)
JB-122-PP1-3A(28)
JB-122-EPP1-3A(5)
JB-122-EPP1-3A(4)
JB-126-PP1-3C(44)
JB-126-PP1-3D(74)
JB-126-PP1-3C(75)
JB-126-PP1-3A(78)
JB-126-PP1-3C(76)
JB-126-PP1-3C(77)
JB-126-PP1-3D(80)
JB-126-PP1-3A(79)
JB-126-PP1-3A(73)
JB-126G-PP1-3C(46)
JB-126-PP1-3C(45)
JB-130-HLP1-1(13)
JB-130-HLP1-1(13)
JB-126-PP1-3C(46)
JB-124-EMP2-1(19)
JB-115-PP1-3(24)
PP1-3B
PP1-3D
PP1-3C
JB-122A-PP1-3B(42)
JB-122C-EPP1-3B(11)
JB-122A-PP1-3B(40)
JB-126A-PP1-3D(48)
JB-126B-EPP1-3B(9)
EPP1-3B
JB-126F-3A(8)
EPP1-1 (LS)
EHLP1-1 (LS)
EHMP1-1 (OS)
EMP1-1 (OS)
EPP1-3A (OS-LAB)
JB-130-EMP2-1(17)
JB-130-MP1-1(58)
JB-130-PP1-3A(34)
JB-130-PP1-2(52)
JB-130-HLP1-1(13)
JB-230-EHLP1-1(7,9)
JB-130-PP1-3A(38)
JB-130-PP1-2(53)
JB-194-MP1-1(59)
JB-128C-PP1-3D(50)
JB-122C-EPP1-3B(11)
JB-128D-EPP1-3B(10)
JB-128D-PP1-3D(49)
JB-122C-PP1-3B(43)
JB-122B-PP1-3B(41)
JB-128B-EPP1-3B(9)
JB-128B-PP1-3D(51)
JB-192-PP1-3A(39)
PP1-2
PP1-1
EPP1-2 (OS)
JB-121-PP1-3A(27)
OAS/ERRCS SPACE
HMP1-1
PP1-3A
SECURITY SPACE
MP1-1
HLP1-1
JB-127-EMP1-1 (16)
JB-127-EMP1-1 (15)
BRANCH: EHMP5-2 (2)
BRANCH: EHMP1-1 (4)
JB-131-PP1-2(55)
JB-131-PP1-3A(33)
JB-131-MP1-1(57)
JB-131-HLP1-1(13)
JB-131-EHLP1-1(14)
JB-131B-EPP1-1(2)
JB-133-PP1-3A(36)
JB-133-MP1-1(57A)
JB-133-EMP2-1(18)
JB-133-EHLP1-1(14)
JB-135C-PP1-2(54)
JB-133-HLP1-1(13)
JB-133C-HLP1-1(13)
JB-133C-EHLP1-1(12,14)
JB-133-PP1-3A(37)
JB-133C-MP1-1(57B)
JB-133-MP1-1(57A)
JB-133-HLP1-1(13)
JB-133-EHLP1-1(14)
JB-192-PP1-2(26)
MECH ROOM 124A
SEAWATER LAB 124
FIELD STAGING 125
LAB SUPPORT 129G
OFFICE 130B
STOR 130C
OFFICE 130D
OFFICE 130E
WORKSTATIONS 130
OFFICE 130F
PUDDLE 130G
ROOM 118
KITCHENETTE 122A
LAB SUPPORT 122A
SAMPLE PREP 122B
MICROSCOPE ROOM 126D
LAB ENTRY 126A
CORRIDOR 132
STAIR 4 133S
PLUMBING 127
WORKSTATIONS 135C
OFFICE 135A
OFFICE 135B
TELDATA 121
ELEV2 102E
SHAFT SHAFT A
Z7
Z8
Z6
D.6
E.8
E.9
G.9
H
H.3
J
J.4
1.15
K
L
6
6.5
7
8
9
10
10.8
11
11.5
12
F
G
J.1
J.2
J.5
K.1
K.4