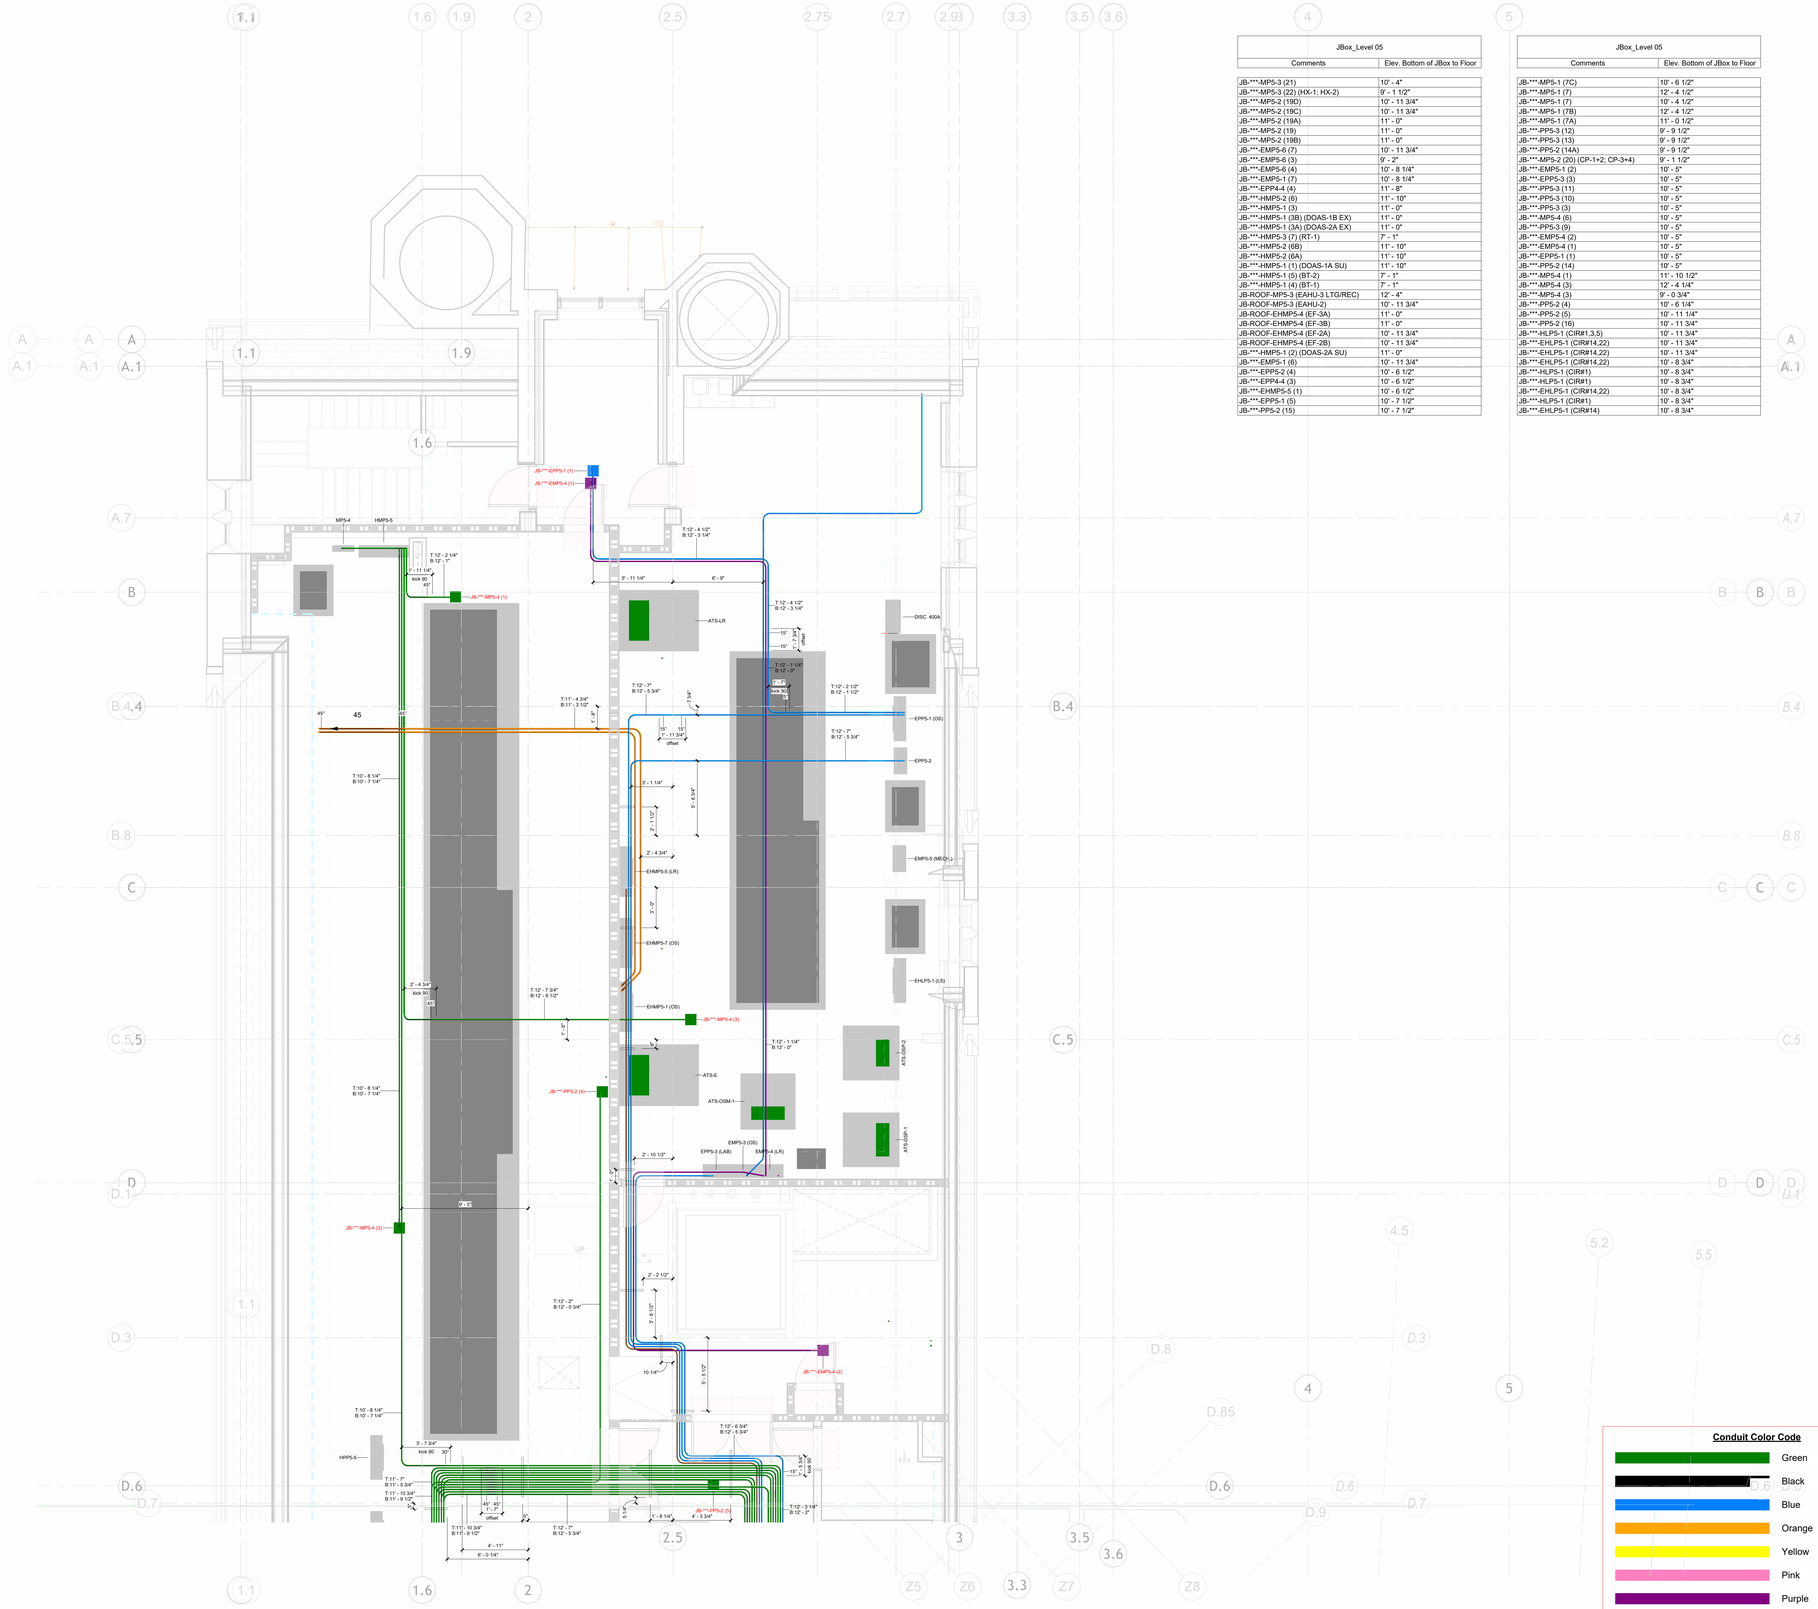


1 LEVEL 05A - BRANCH
1/4" = 1'-0"

| JBox_Level 05 | |
|---|---|
| Comments | Elev. Bottom of JBox to Floor |
| JB-***-MP5-3 (21) | 10' - 4" |
| JB-***-MP5-3 (22) (HX-1; HX-2) | 9' - 1 1/2" |
| JB-***-MP5-2 (19D) | 10' - 11 3/4" |
| JB-***-MP5-2 (19C) | 10' - 11 3/4" |
| JB-***-MP5-2 (19A) | 11' - 0" |
| JB-***-MP5-2 (19) | 11' - 0" |
| JB-***-MP5-2 (19B) | 11' - 0" |
| JB-***-EMP5-6 (7) | 10' - 11 3/4" |
| JB-***-EMP5-6 (3) | 9' - 2" |
| JB-***-EMP5-6 (4) | 10' - 8 1/4" |
| JB-***-EMP5-1 (7) | 10' - 8 1/4" |
| JB-***-EPP4-4 (4) | 11' - 8" |
| JB-***-HMP5-2 (6) | 11' - 10" |
| JB-***-HMP5-1 (3) | 11' - 0" |
| JB-***-HMP5-1 (3B) (DOAS-1B EX) | 11' - 0" |
| JB-***-HMP5-1 (3A) (DOAS-2A EX) | 11' - 0" |
| JB-***-HMP5-3 (7) (RT-1) | 7' - 1" |
| JB-***-HMP5-2 (6B) | 11' - 10" |
| JB-***-HMP5-2 (6A) | 11' - 10" |
| JB-***-HMP5-1 (1) (DOAS-1A SU) | 11' - 10" |
| JB-***-HMP5-1 (5) (BT-2) | 7' - 1" |
| JB-***-HMP5-1 (4) (BT-1) | 7' - 1" |
| JB-ROOF-MP5-3 (EAHU-3 LTG/REC) | 12' - 4" |
| JB-ROOF-MP5-3 (EAHU-2) | 10' - 11 3/4" |
| JB-ROOF-EHMP5-4 (EF-3A) | 11' - 0" |
| JB-ROOF-EHMP5-4 (EF-3B) | 11' - 0" |
| JB-ROOF-EHMP5-4 (EF-2A) | 10' - 11 3/4" |
| JB-ROOF-EHMP5-4 (EF-2B) | 10' - 11 3/4" |
| JB-***-HMP5-1 (2) (DOAS-2A SU) | 11' - 0" |
| JB-***-EMP5-1 (6) | 10' - 11 3/4" |
| JB-***-EPP5-2 (4) | 10' - 6 1/2" |
| JB-***-EPP4-4 (3) | 10' - 6 1/2" |
| JB-***-EHMP5-5 (1) | 10' - 6 1/2" |
| JB-***-EPP5-1 (5) | 10' - 7 1/2" |
| JB-***-PP5-2 (15) | 10' - 7 1/2" |

| JBox_Level 05 | |
|---|---|
| Comments | Elev. Bottom of JBox to Floor |
| JB-***-MP5-1 (7C) | 10' - 6 1/2" |
| JB-***-MP5-1 (7) | 12' - 4 1/2" |
| JB-***-MP5-1 (7) | 10' - 4 1/2" |
| JB-***-MP5-1 (7B) | 12' - 4 1/2" |
| JB-***-MP5-1 (7A) | 11' - 0 1/2" |
| JB-***-PP5-3 (12) | 9' - 9 1/2" |
| JB-***-PP5-3 (13) | 9' - 9 1/2" |
| JB-***-PP5-2 (14A) | 9' - 9 1/2" |
| JB-***-MP5-2 (20) (CP-1+2; CP-3+4) | 9' - 1 1/2" |
| JB-***-EMP5-1 (2) | 10' - 5" |
| JB-***-EPP5-3 (3) | 10' - 5" |
| JB-***-PP5-3 (11) | 10' - 5" |
| JB-***-PP5-3 (10) | 10' - 5" |
| JB-***-PP5-3 (3) | 10' - 5" |
| JB-***-MP5-4 (6) | 10' - 5" |
| JB-***-PP5-3 (9) | 10' - 5" |
| JB-***-EMP5-4 (2) | 10' - 5" |
| JB-***-EMP5-4 (1) | 10' - 5" |
| JB-***-EPP5-1 (1) | 10' - 5" |
| JB-***-PP5-2 (14) | 10' - 5" |
| JB-***-MP5-4 (1) | 11' - 10 1/2" |
| JB-***-MP5-4 (3) | 12' - 4 1/4" |
| JB-***-MP5-4 (3) | 9' - 0 3/4" |
| JB-***-PP5-2 (4) | 10' - 6 1/4" |
| JB-***-PP5-2 (5) | 10' - 11 1/4" |
| JB-***-PP5-2 (16) | 10' - 11 3/4" |
| JB-***-HLP5-1 (CIR#1,3,5) | 10' - 11 3/4" |
| JB-***-EHLP5-1 (CIR#14,22) | 10' - 11 3/4" |
| JB-***-EHLP5-1 (CIR#14,22) | 10' - 11 3/4" |
| JB-***-EHLP5-1 (CIR#14,22) | 10' - 8 3/4" |
| JB-***-HLP5-1 (CIR#1) | 10' - 8 3/4" |
| JB-***-HLP5-1 (CIR#1) | 10' - 8 3/4" |
| JB-***-EHLP5-1 (CIR#14,22) | 10' - 8 3/4" |
| JB-***-HLP5-1 (CIR#1) | 10' - 8 3/4" |
| JB-***-EHLP5-1 (CIR#14) | 10' - 8 3/4" |

**Conduit Color Code**

| | | |
|---|---|---|
| Green | Normal | 208/120V |
| Black | Normal | 480/277V |
| Blue | EM | 208/120V |
| Orange | EM | 480/277V |
| Yellow | LS | 208/120V |
| Pink | LS | 480/277V |
| Purple | LR | 208/120V |
| Brown | LR | 480/277V |
| Red | FA | |
| Magenta | TELCOM | |
| Cyan | ATS | |


DINTO ELECTRICAL CONTRACTORS
**Paul Dinto Electrical Contractors, Inc.**
121 Turnpike Drive |Middlebury, CT | 06762


| No. | Description | Date |
|---|---|---|
| | | |

# YALE OML

# ELECTRICAL

# BRANCH

| | |
|---|---|
| Project Number | 39022 |
| Date | 5/13/26 |
| Drawn By | Author |
| Checked By | Checker |

# E35_05A

| | |
|---|---|
| Scale | As indicated |

5/13/2026 12:50:24 PM