
HIGHLIGHTED AREAS ARE COMPLETED

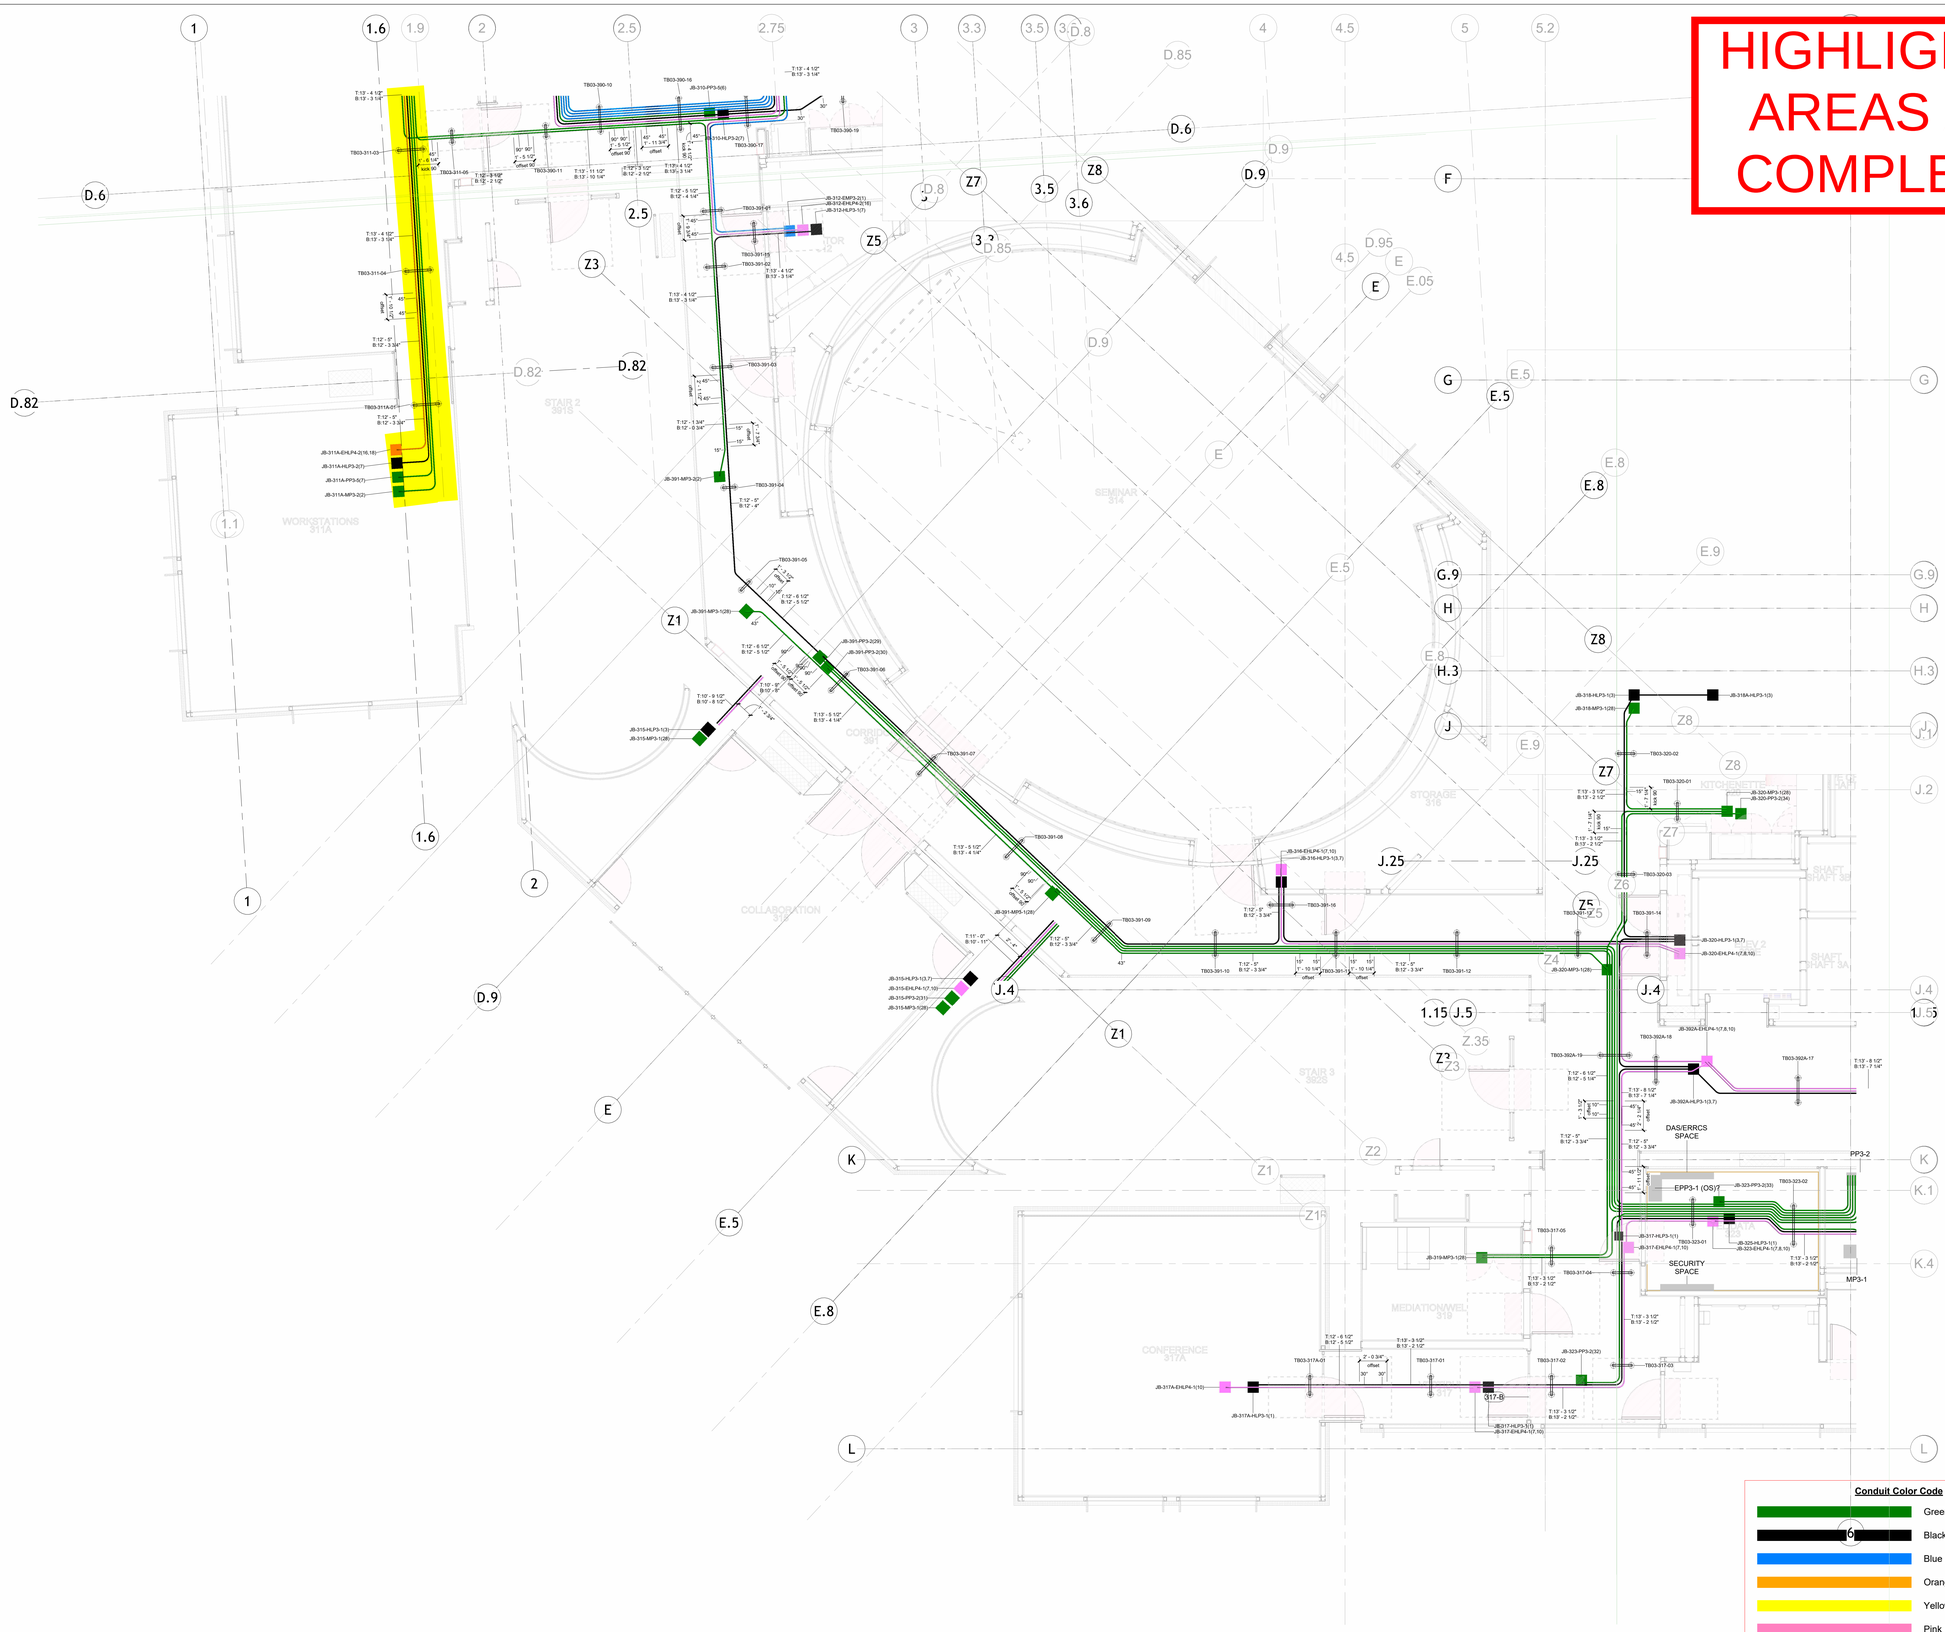

1 LEVEL 03B - BRANCH
1/4" = 1'-0"

DINTO ELECTRICAL CONTRACTORS
Paul Dinto Electrical Contractors, Inc.
121 Turnpike Drive |Middlebury, CT | 06762

No.	Description	Date

YALE OML

ELECTRICAL

BRANCH

Project Number	39022
Date	6/22/26
Drawn By	Author
Checked By	Checker

E35_03B

Scale: As indicated

7/12/2026 11:28:46 PM