
HIGHLIGHTED AREAS ARE COMPLETED

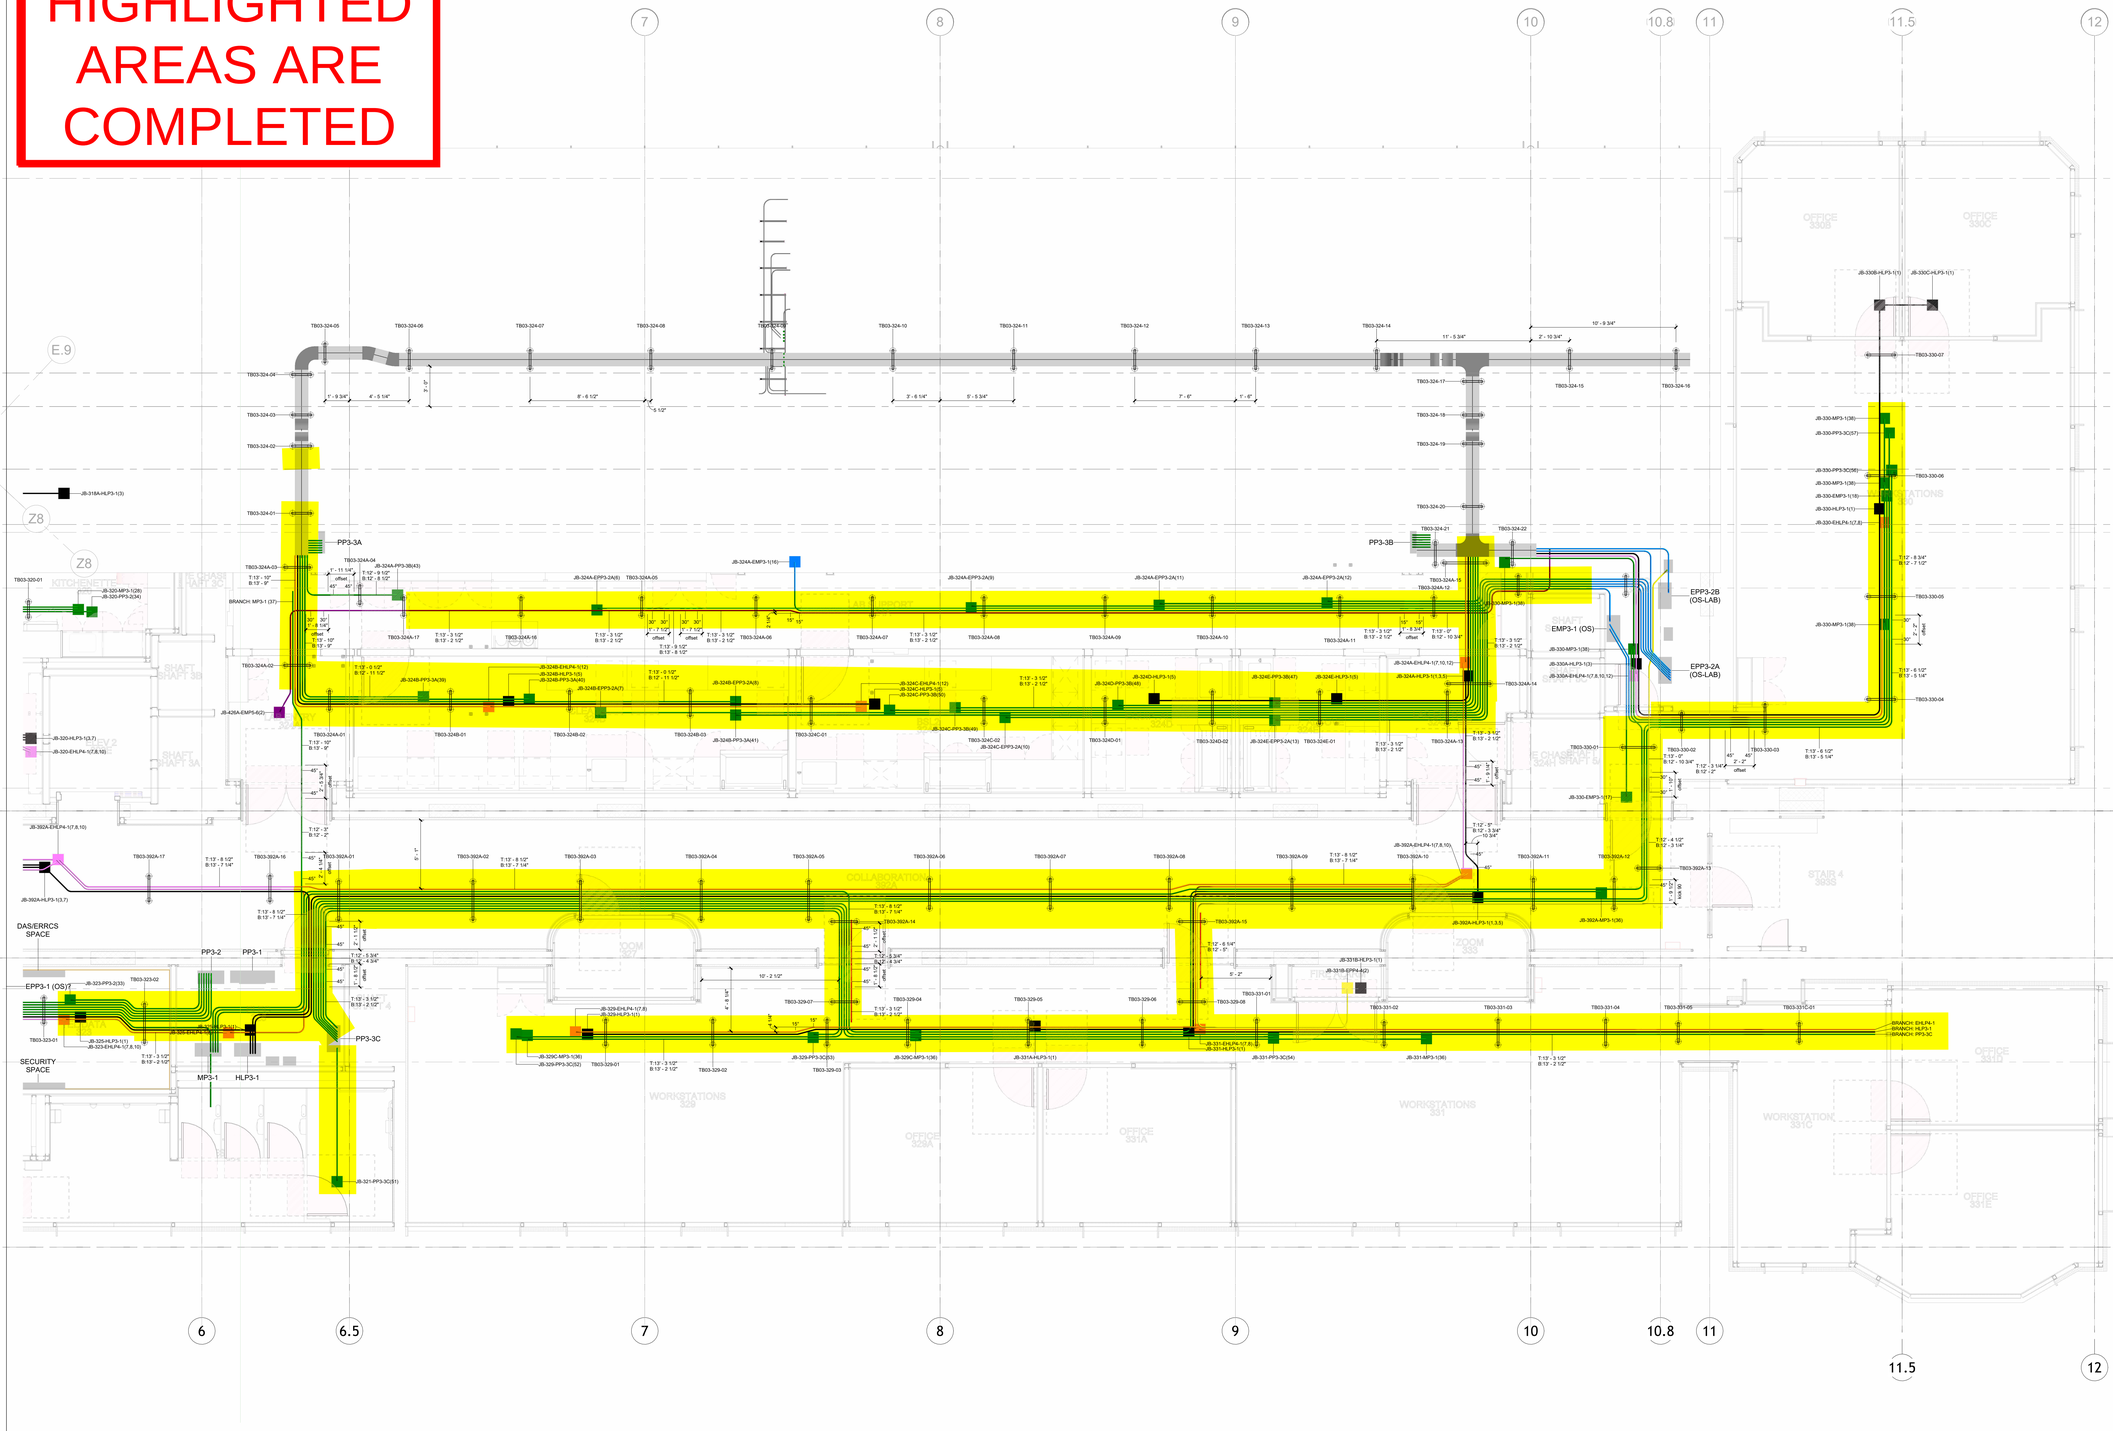

1 LEVEL 03C - BRANCH
1/4" = 1'-0"

Conduit Color Code

Green	Normal	208/120V
Black	Normal	480/277V
Blue	EM	208/120V
Orange	EM	480/277V
Yellow	LS	208/120V
Pink	LS	480/277V
Purple	LR	208/120V
Brown	LR	480/277V
Red	FA	
Magenta	TELCOM	
Cyan	ATS	

DINTO ELECTRICAL CONTRACTORS
Paul Dinto Electrical Contractors, Inc.
121 Turnpike Drive |Middlebury, CT | 06762

No.	Description	Date

YALE OML

ELECTRICAL

BRANCH

Project Number	39022
Date	6/22/26
Drawn By	Author
Checked By	Checker

E35_03C

Scale	As indicated

7/12/2026 11:29:32 PM