
HIGHLIGHTED AREAS ARE COMPLETED

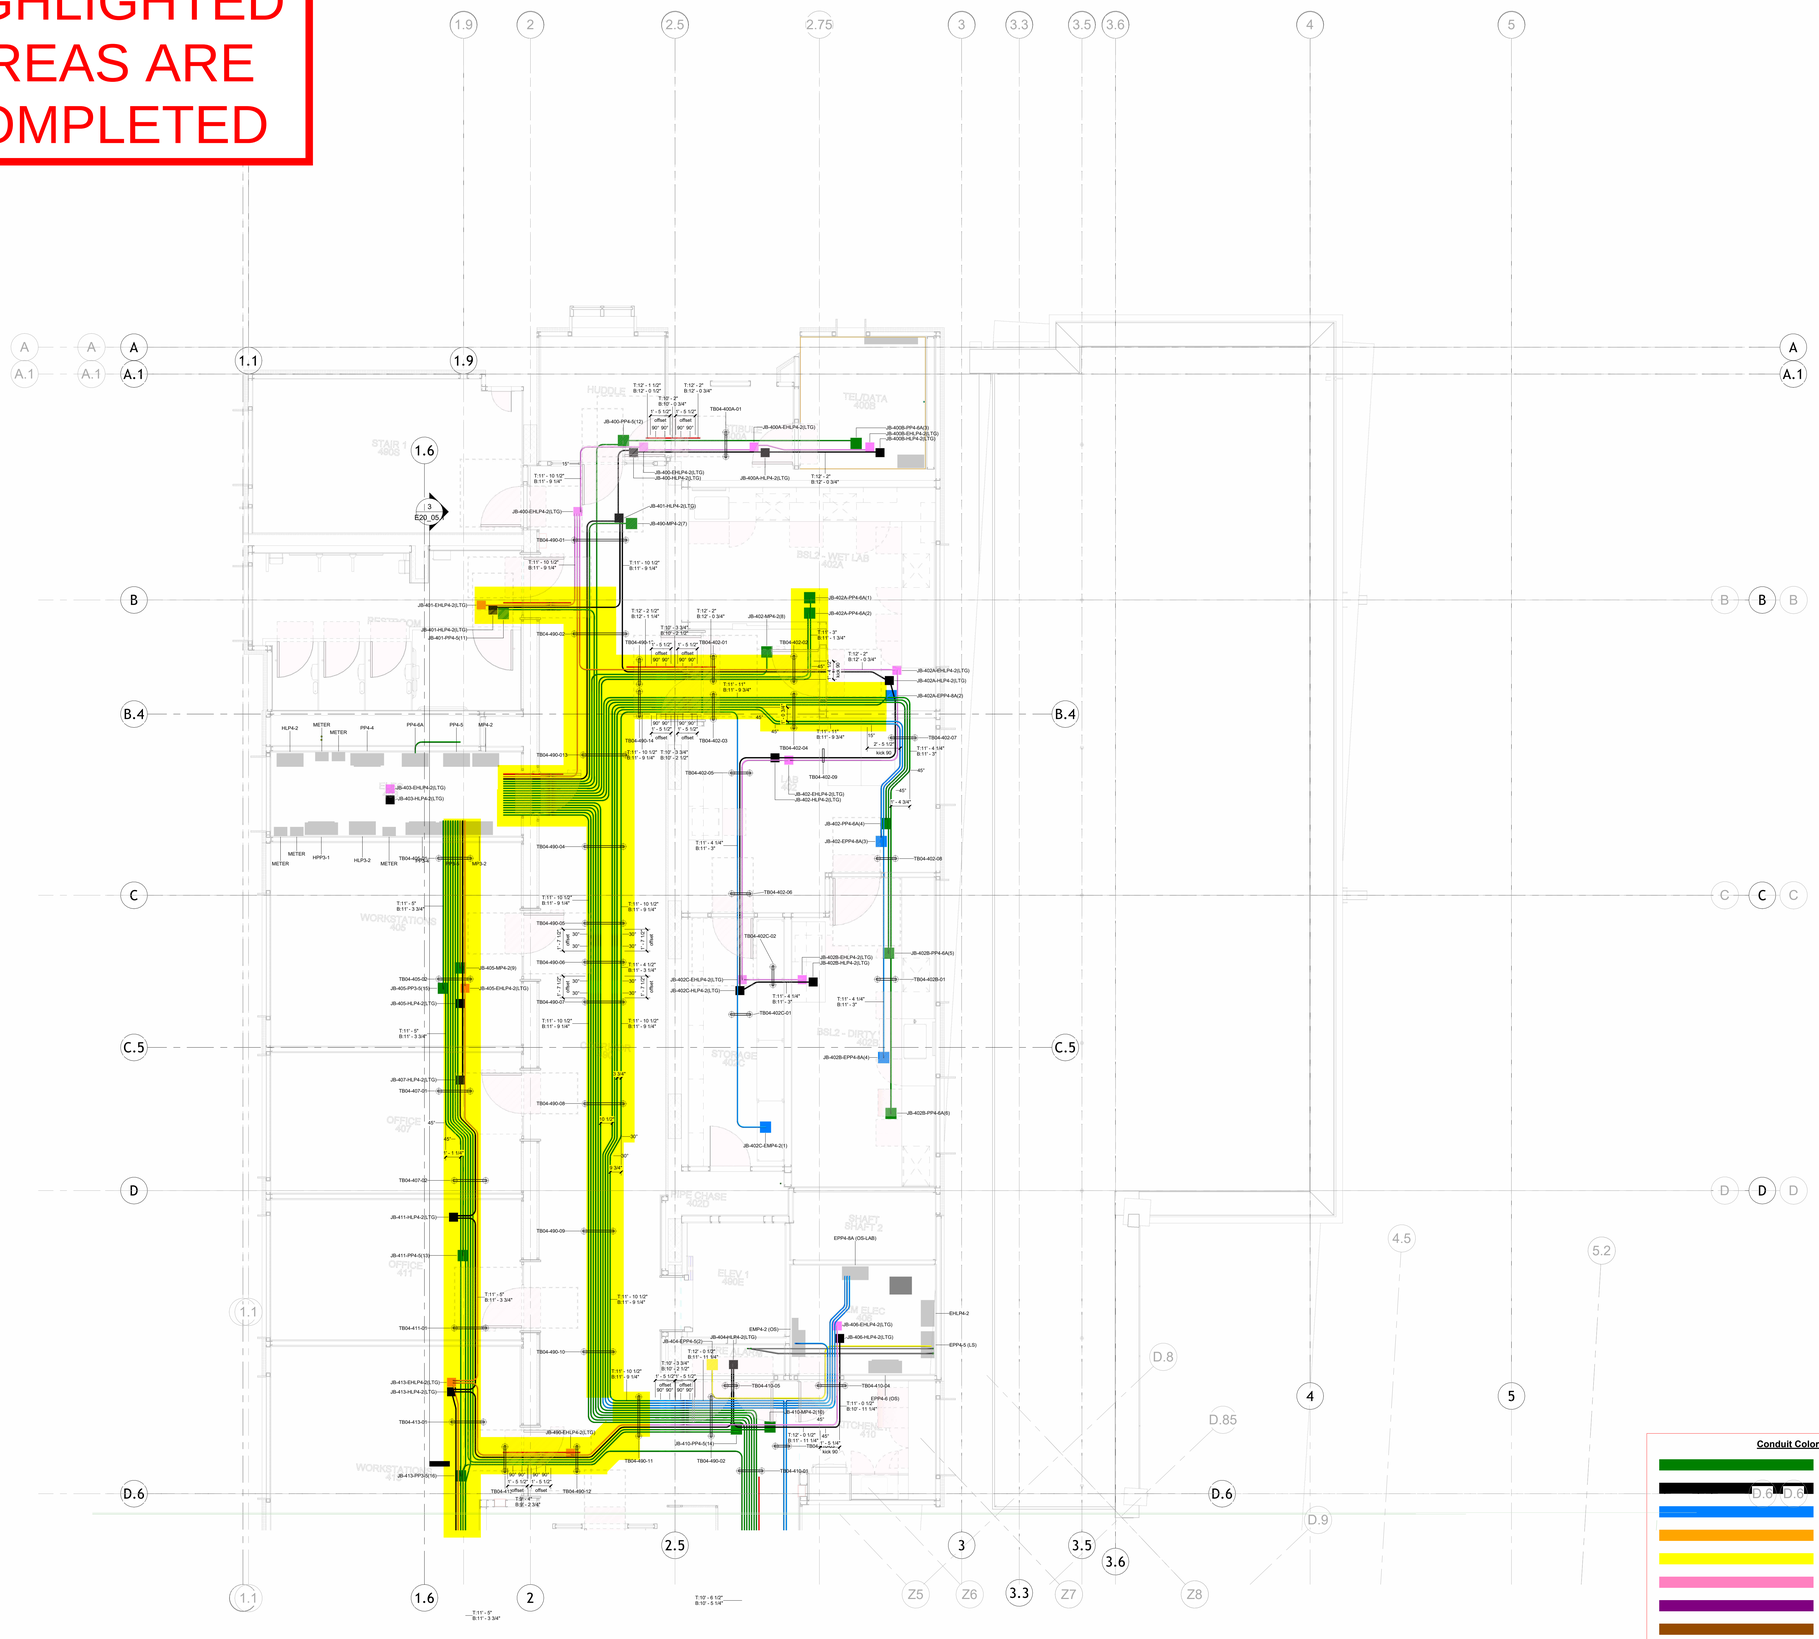


1 LEVEL 04A - BRANCH
1/4" = 1'-0"

**Conduit Color Code**

| | | |
|---|---|---|
| Green | Normal | 208/120V |
| Black | Normal | 480/277V |
| Blue | EM | 208/120V |
| Orange | EM | 480/277V |
| Yellow | LS | 208/120V |
| Pink | LS | 480/277V |
| Purple | LR | 208/120V |
| Brown | LR | 480/277V |
| Red | FA | |
| Magenta | TELCOM | |
| Cyan | ATS | |


DINTO ELECTRICAL CONTRACTORS
**Paul Dinto Electrical Contractors, Inc.**
121 Turnpike Drive |Middlebury, CT | 06762


| No. | Description | Date |
|---|---|---|

# YALE OML

## ELECTRICAL

## BRANCH

| | |
|---|---|
| Project Number | 39022 |
| Date | 6/17/26 |
| Drawn By | Author |
| Checked By | Checker |

# E35_04A

Scale: As indicated

6/17/2026 11:02:39 PM