


HIGHLIGHTED AREAS ARE COMPLETED

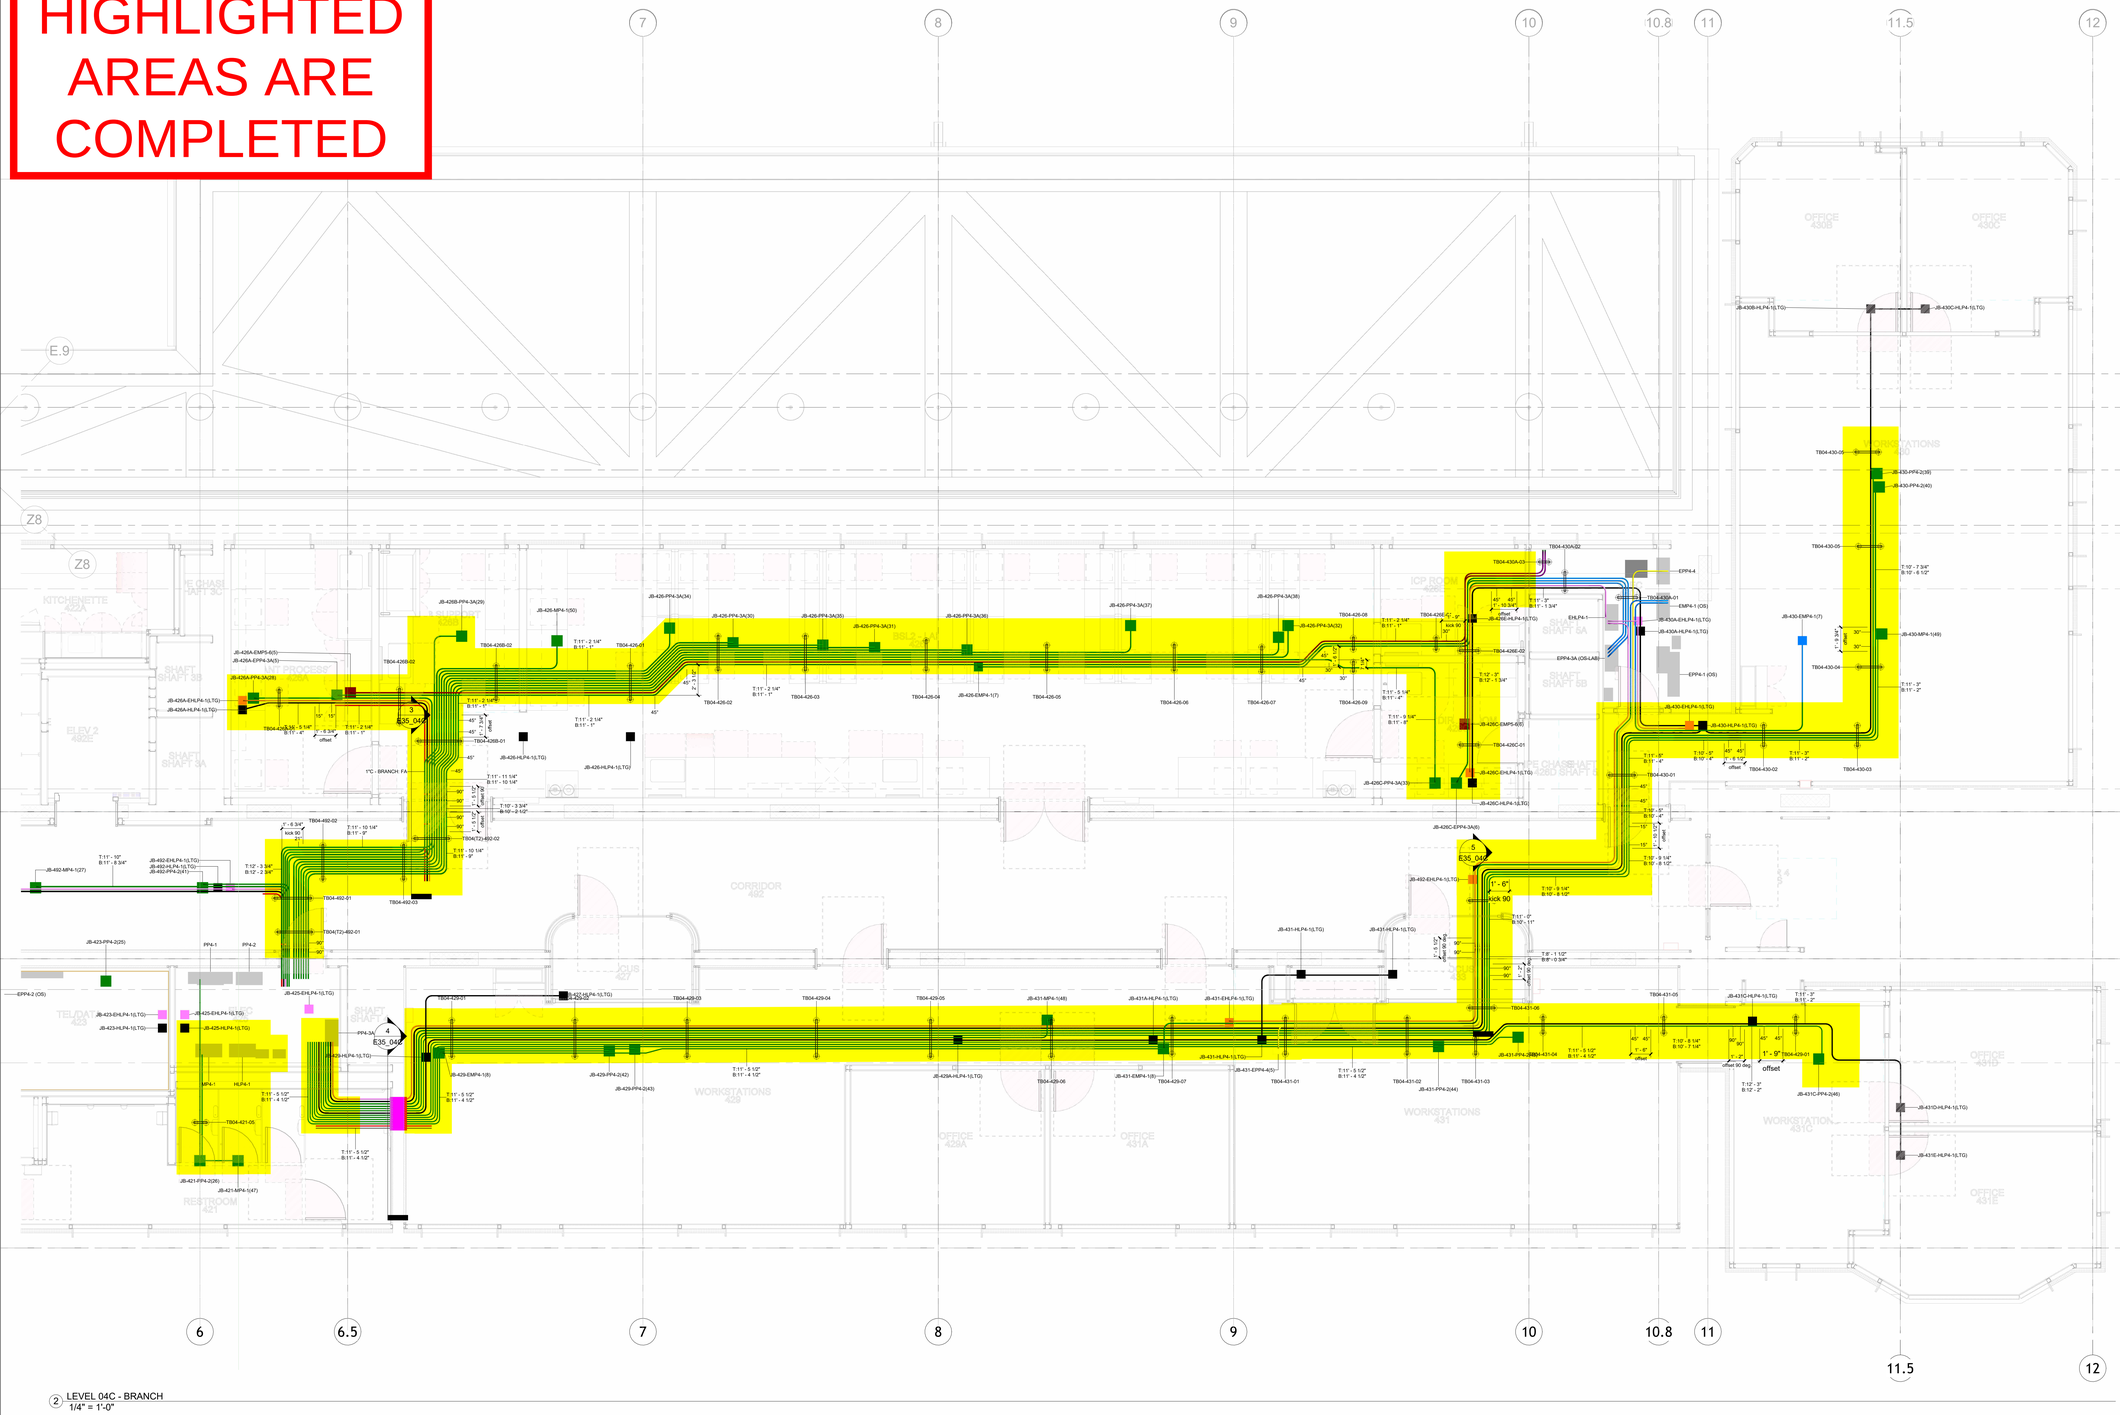


2 LEVEL 04C - BRANCH
1/4" = 1'-0"

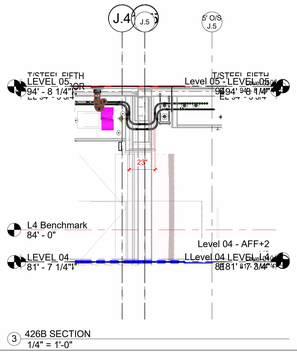

3 426B SECTION
1/4" = 1'-0"

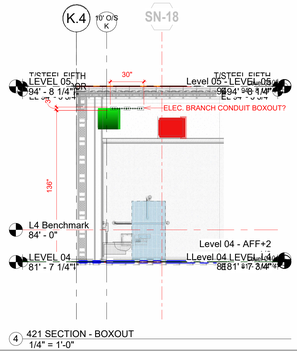

4 421 SECTION - BOXOUT
1/4" = 1'-0"

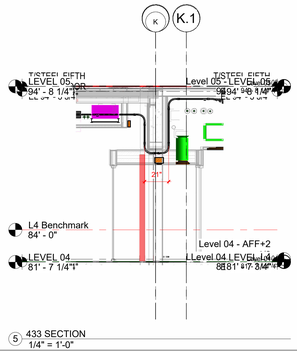

5 433 SECTION
1/4" = 1'-0"

Conduit Color Code

Green	Normal	208/120V
Black	Normal	480/277V
Blue	EM	208/120V
Orange	EM	480/277V
Yellow	LS	208/120V
Pink	LS	480/277V
Purple	LR	208/120V
Brown	LR	480/277V
Red	FA	
Magenta	TELCOM	
Cyan	ATS	

DINTO ELECTRICAL CONTRACTORS
Paul Dinto Electrical Contractors, Inc.
121 Turnpike Drive |Middlebury, CT | 06762

No.	Description	Date

YALE OML

ELECTRICAL

BRANCH

Project Number	39022
Date	6/17/26
Drawn By	Author
Checked By	Checker

E35_04C

Scale: As indicated

6/17/2026 11:05:17 PM