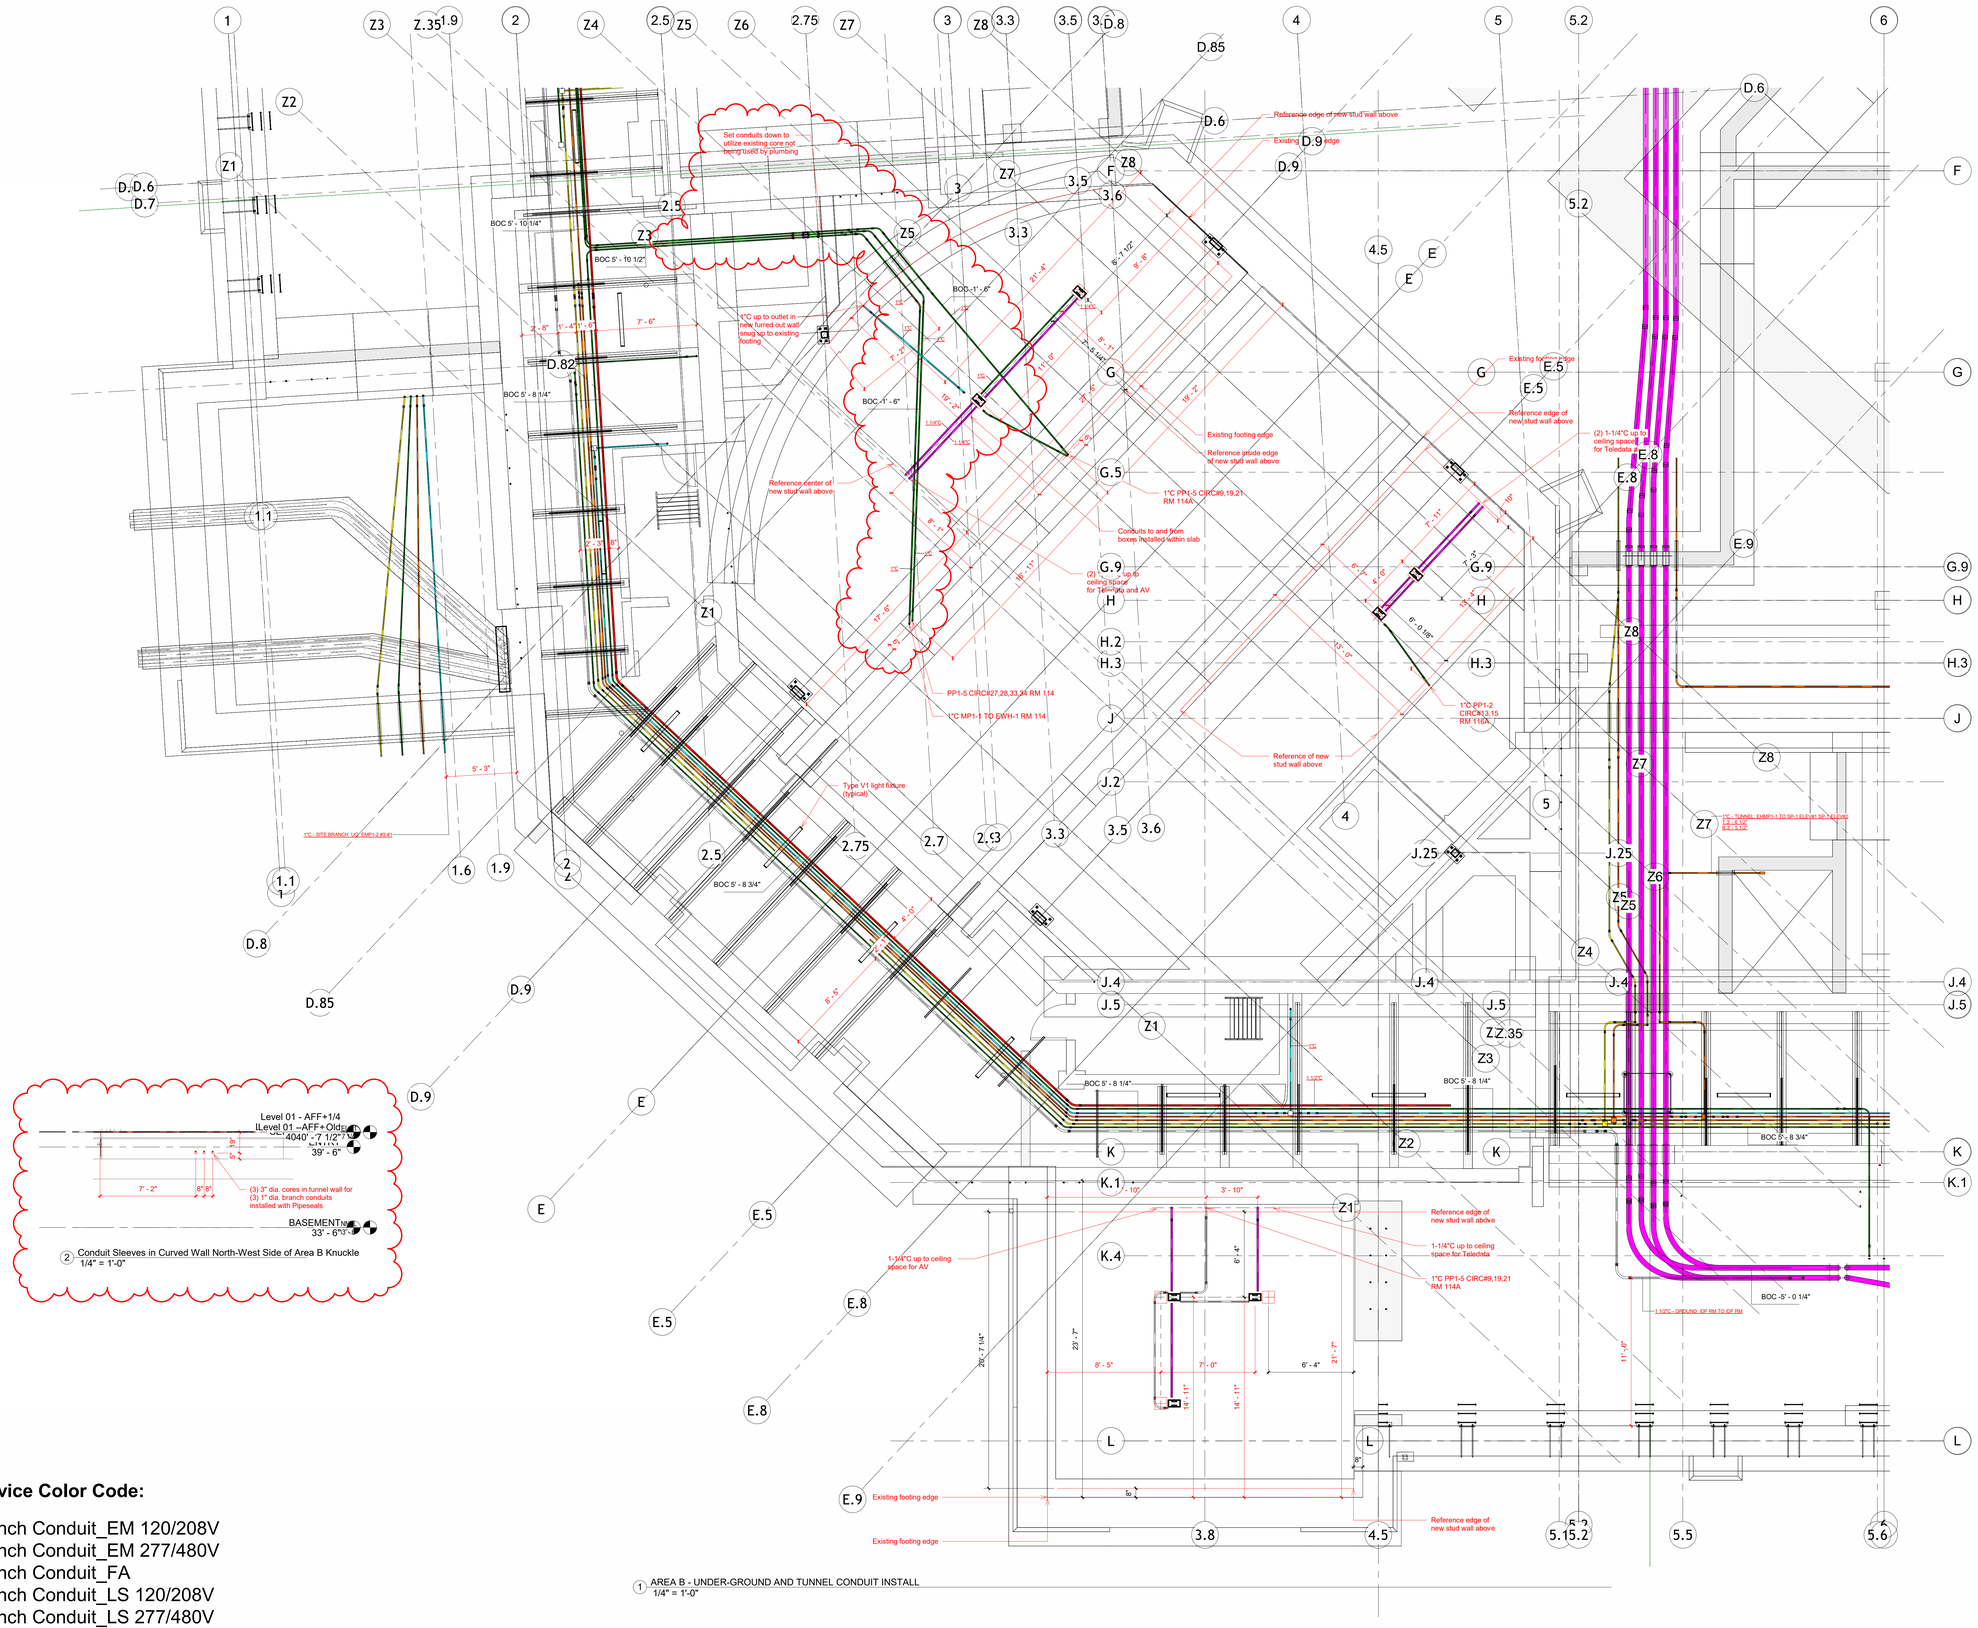


Conduit Service Color Code:

- Branch Conduit_EM 120/208V
- Branch Conduit_EM 277/480V
- Branch Conduit_FA
- Branch Conduit_LS 120/208V
- Branch Conduit_LS 277/480V
- Branch Conduit_Normal 120/208V
- Branch Conduit_Normal 277/480V
- TELECOM

Yale

Central Campus

Office of Facilities
2 Whitney Avenue
New Haven, CT 06520

HGA

374 Congress St, Suite 400
Boston, MA 02210
Telephone 617.338.5990

CIVIL ENGINEER
NITSCH ENGINEERING
370 MAIN STREET, SUITE 850
WORCESTER, MA 01608
508.639.8044

LANDSCAPE ARCHITECT
TOWERS | GOLDE
85 WILLOW STREET, STE 2 BLDG 51
NEW HAVEN, CT 06511
203.773.1153

MEP-FP ENGINEER
R.G. VANDERWEIL ENGINEERS
274 SUMMER STREET
BOSTON, MA 02210
617.423.7423

STRUCTURAL ENGINEER
THORNTON TOMASETTI
101 ARCH STREET, SUITE 1600,
BOSTON, MA 02210-1668
617.250.4100

CODE CONSULTANT
JENSEN HUGHES
33 ARCH STREET
BOSTON MA 02110
508.538.9220

AV, IT & SEC ENGINEER
SHEN MILSOM & WILKE
275 MADISON AVENUE,
14TH FLOOR
NEW YORK, NY 10016
212.725.6800



KEYPLAN

NO	DESCRIPTION	DATE
1	Revised branch & added sleeves	10/21/2025

ISSUANCE HISTORY - THIS SHEET

PROJECT NAME
OSBORN MEMORIAL LABORATORIES - ADDITION AND RENOVATION

BUILDING NAME & ADDRESS
YALE UNIVERSITY
OSBORN MEMORIAL LABORATORIES
165 PROSPECT STREET
NEW HAVEN, CONNECTICUT 06511

HGA PROJECT NUMBER	YALE PROJECT NUMBER
3458-003-00	22020105

DRAWING TITLE
Area B - Under-Ground and Tunnel Conduit Install

SCALE	DRAWN BY
As indicated	JE
CAD FILENAME	DATE
REVIT 2025	10/10/25

DRAWING NUMBER
E-UG-B
PAGE NUMBER

DINTO ELECTRICAL CONTRACTORS
121 Turnpike Drive Middlebury, CT 06762
(203) 575-9473 www.DintoElectric.com

© COPYRIGHT HAMMEL, GREEN AND ABRAHAMSON, INC.

C:\Users\JeffreyEarley\OneDrive - Dinto Electric\01 Current Projects\3022 Yale OM\103 BIM\03 Electrical BIM\YaleOM_ELEC_R2025.rvt
11/25/2025 10:35:39 AM
JE