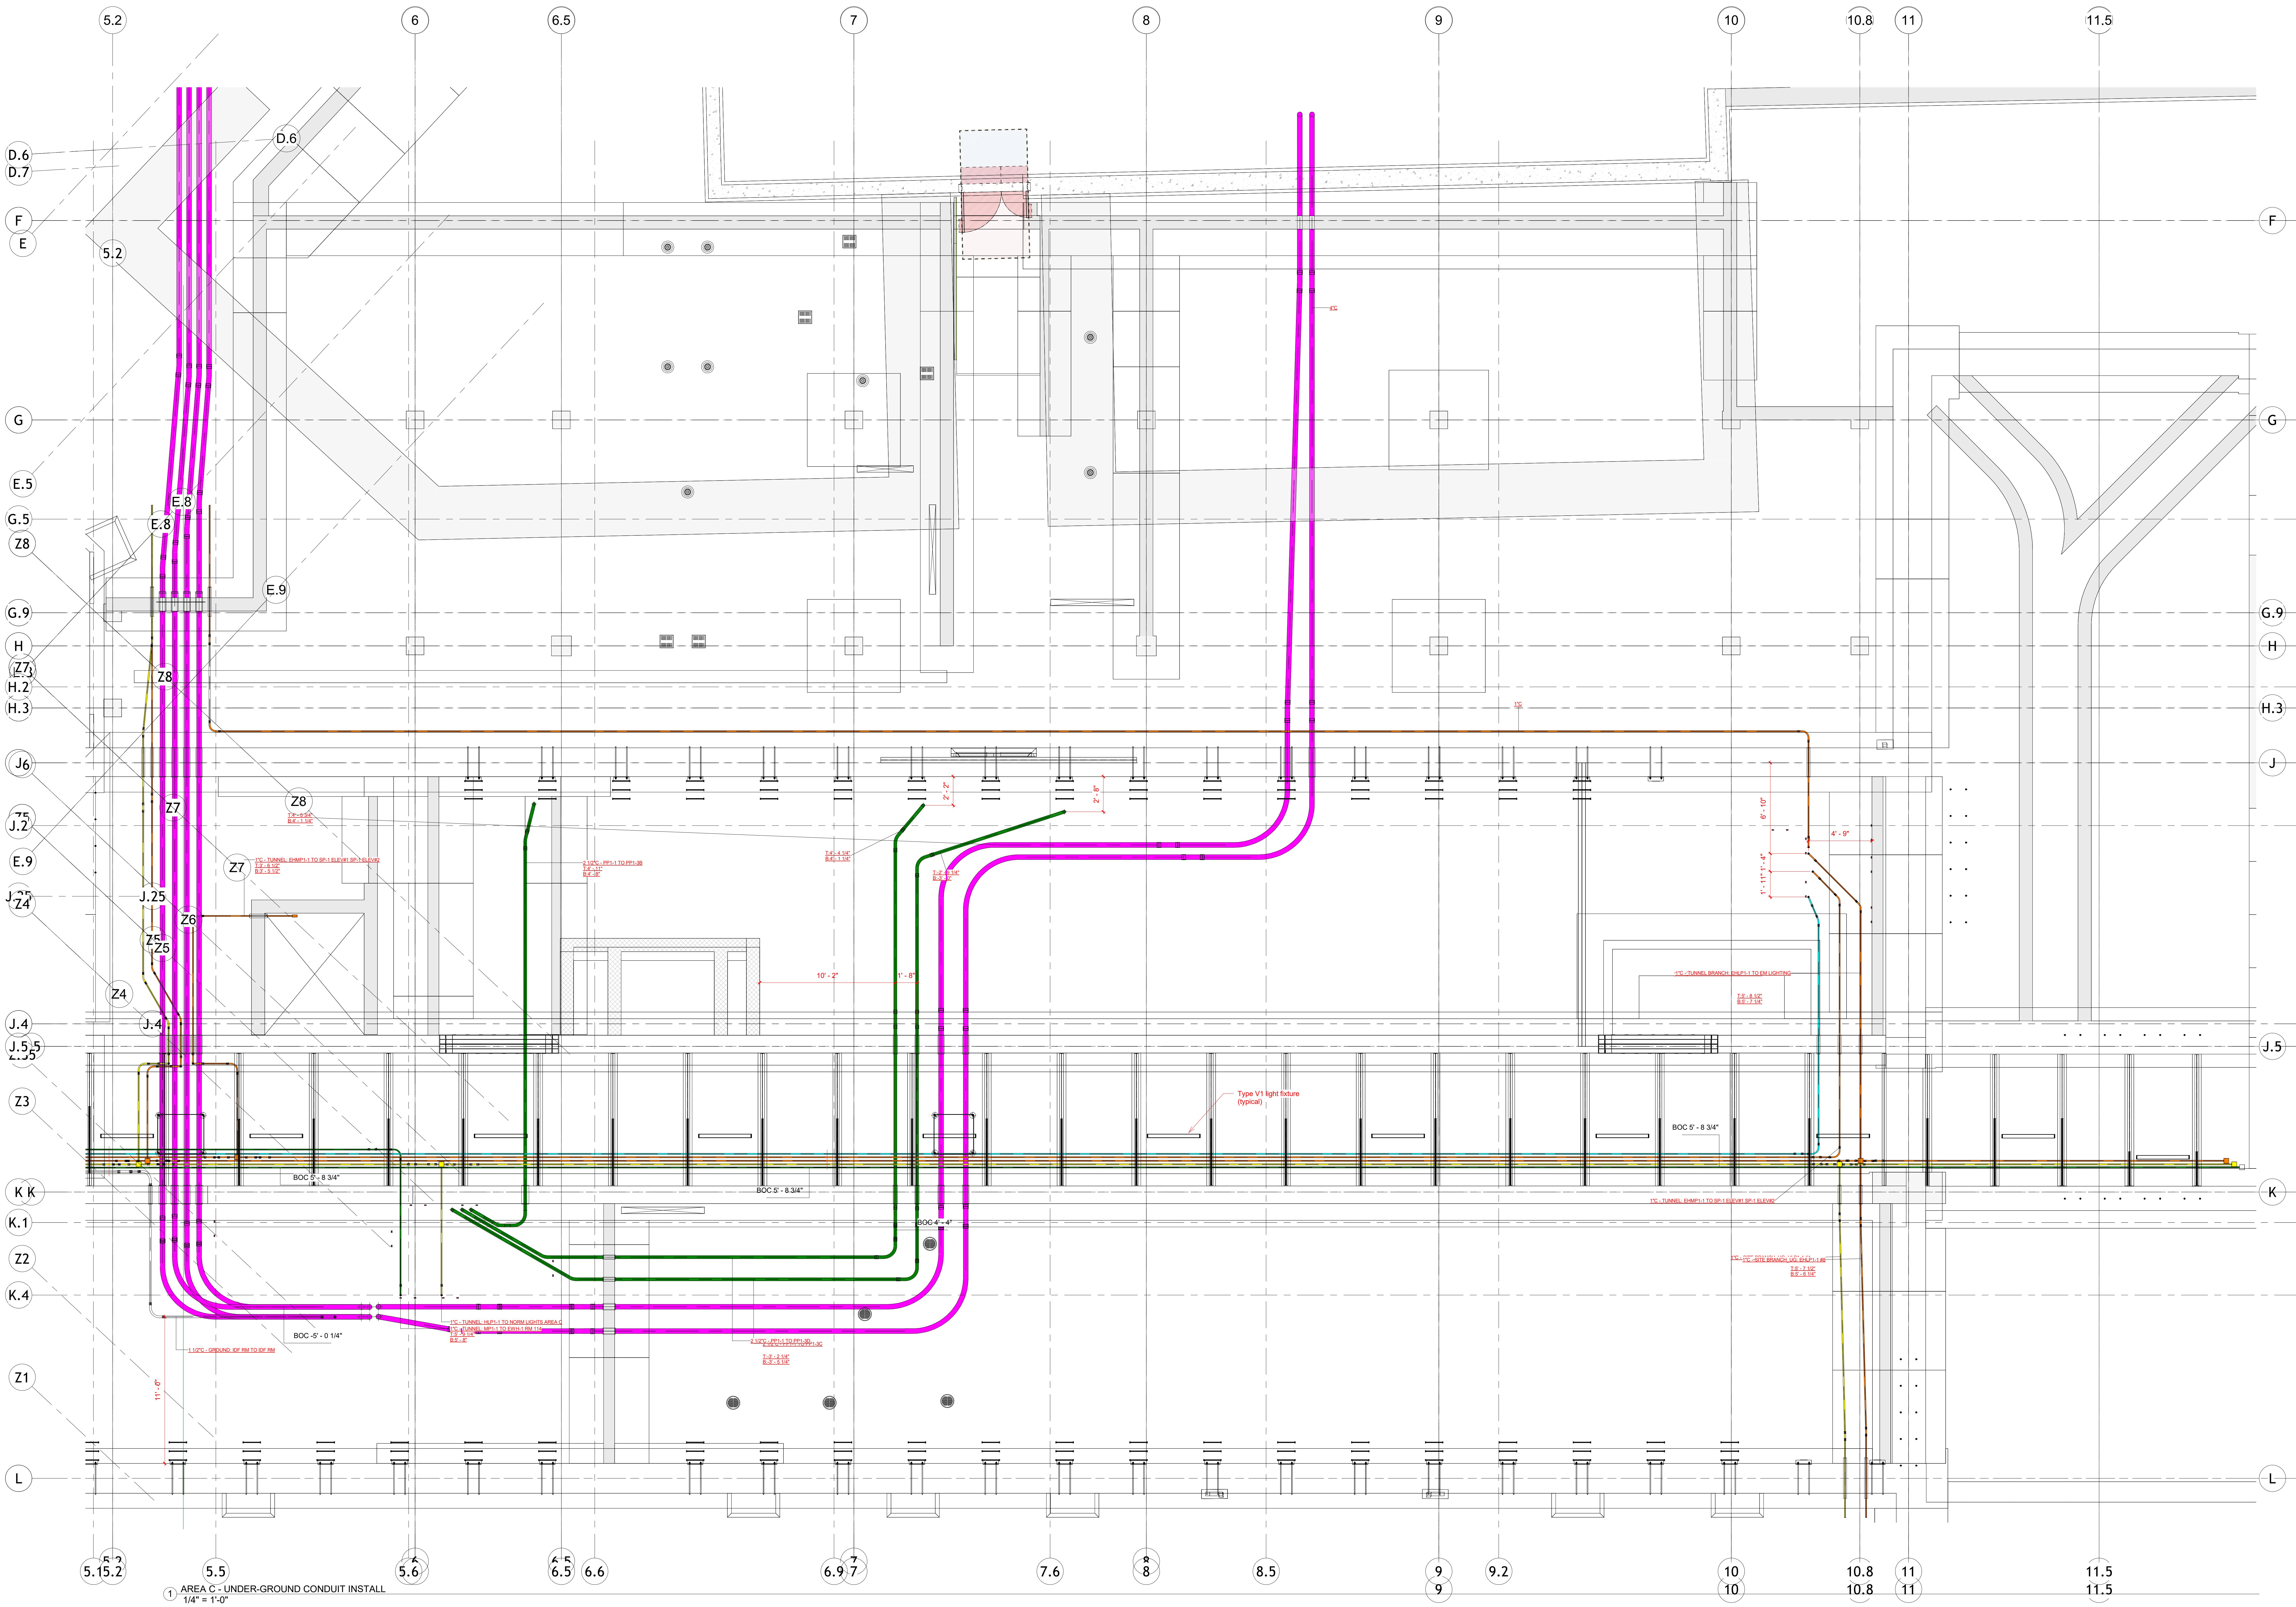

1 AREA C - UNDER-GROUND CONDUIT INSTALL
1/4" = 1'-0"

Conduit Service Color Code:

- 🟦 Branch Conduit_EM 120/208V
- 🟧 Branch Conduit_EM 277/480V
- 🟥 Branch Conduit_FA
- 🟩 Branch Conduit_LS 120/208V
- 🟪 Branch Conduit_LS 277/480V
- 🟩 Branch Conduit_Normal 120/208V
- 🟨 Branch Conduit_Normal 277/480V
- 🟪 TELECOM

C:\Users\JeffreyEarley\OneDrive - Dinto Electric\01 Current Projects\39022 Yale OML\03 BIM\00 Electrical BIM\YaleOML_ELEC_R2025.rvt 11/25/2025 10:34:48 AM JE

DINTO
ELECTRICAL CONTRACTORS
121 Turnpike Drive Middlebury, CT 06762
(203) 575-9473 www.DintoElectric.com

Yale

Central Campus

Office of Facilities
2 Whitney Avenue
New Haven, CT 06520

HGA

374 Congress St, Suite 400
Boston, MA 02210
Telephone 617.338.5990

CIVIL ENGINEER
NITSCH ENGINEERING
370 MAIN STREET, SUITE 850
WORCESTER, MA 01608
508.639.8044

LANDSCAPE ARCHITECT
TOWERS | GOLDE
85 WILLOW STREET, STE 2 BLDG 51
NEW HAVEN, CT 06511
203.773.1153

MEP-FP ENGINEER
R.G. VANDERWEIL ENGINEERS
274 SUMMER STREET
BOSTON, MA 02210
617.423.7423

STRUCTURAL ENGINEER
THORNTON TOMASETTI
101 ARCH STREET, SUITE 1600,
BOSTON, MA 02210-1668
617.250.4100

CODE CONSULTANT
JENSEN HUGHES
33 ARCH STREET
BOSTON MA 02110
508.538.9220

AV, IT & SEC ENGINEER
SHEN MILSOM & WILKE
275 MADISON AVENUE
14TH FLOOR
NEW YORK, NY 10016
212.725.6800

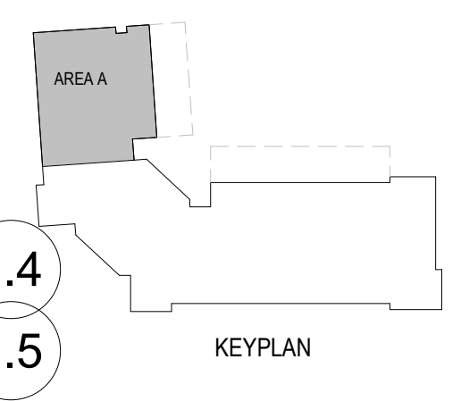

	DESCRIPTION	DATE

ISSUANCE HISTORY - THIS SHEET

PROJECT NAME
OSBORN MEMORIAL LABORATORIES - ADDITION AND RENOVATION

BUILDING NAME & ADDRESS
YALE UNIVERSITY
OSBORN MEMORIAL LABORATORIES
165 PROSPECT STREET
NEW HAVEN, CONNECTICUT 06511

HGA PROJECT NUMBER	YALE PROJECT NUMBER
3458-003-00	**22020105**

DRAWING TITLE
Area C - Under-Ground & Tunnel Conduit Install

SCALE	DRAWN BY
As indicated	JE
CAD FILENAME	**DATE**
REVIT 2025	10/10/25

DRAWING NUMBER
E-UG-C
PAGE NUMBER

© COPYRIGHT HAMMEL, GREEN AND ABRAHAMSON, INC.